



WEST 137th STREET

NEW PATIENT
PAVILION
(48,104.08 SF)

RON BROWN
(26,450.00 SF)

EXIT
DISCHARGEEXIT
DISCHARGE

~~EXIT~~
~~DISCHARGE~~

EXIT
DISCHARGE

EXIT
DISCHARGE

3

MLK
(50,526.00 SF)

NEW YORK CITY
HEALTH AND HOSPITALS
CORPORATION
125 WORTH STREET
NEW YORK, N.Y. 10013

HARLEM HOSPITAL CENTER
AMBULATORY CARE BUILDING
506 LENOX AVENUE
NEW YORK, N.Y. 10037

COLES/URS

Robert Traynham Coles, Architect, P.C.
URS Consultants, Inc.

A JOINT VENTURE
62 COOPER SQUARE - 11
NEW YORK, N.Y. 10003


CIVIL ENGINEER
URS CONSULTANTS, INC.
ONE PENN PLAZA, SUITE 610
NEW YORK, NY 10119-0118

STRUCTURAL ENGINEER
URS CONSULTANTS, INC.
23355 MERCANTILE ROAD
CLEVELAND OHIO 44122-4920


MECHANICAL/ELECTRICAL ENGINEER
HARDIE & ASSOCIATES
838 BROADWAY
NEW YORK, N.Y. 10003

CONSTRUCTION MANAGER
THACKER ENGINEERING, INC.
72 READE STREET - 3RD FLOOR
NEW YORK, N.Y. 10007

SITE KEY PLAN

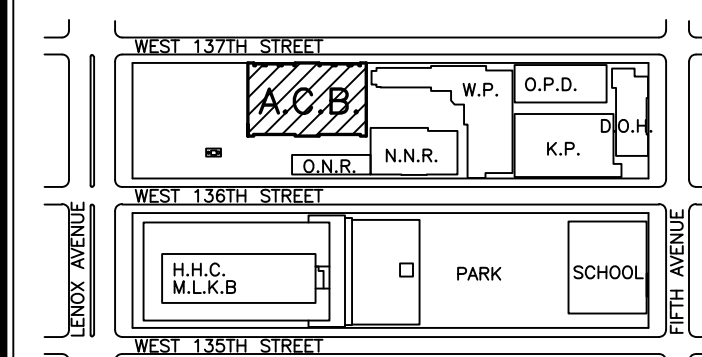

BUILDING KEY PLAN

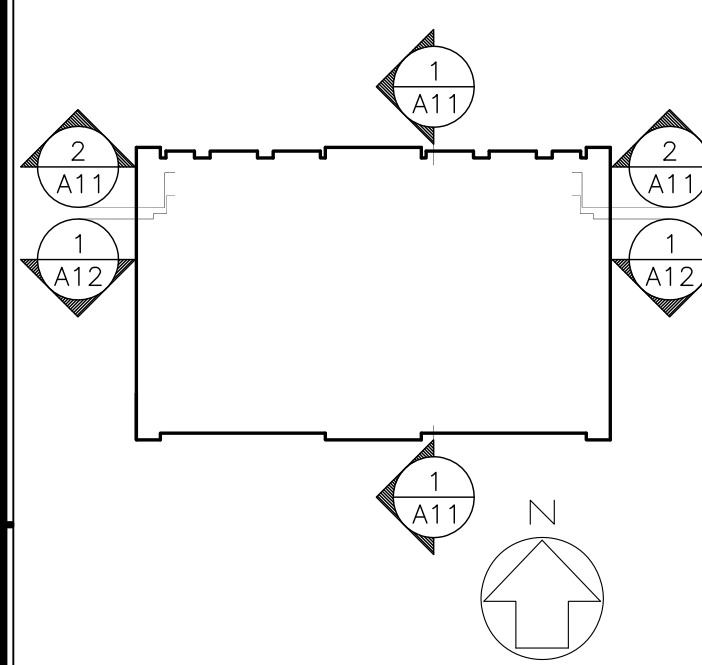

PROJECT

HARLEM HOSPITAL CENTER
AMBULATORY CARE BUILDING
CONSTRUCTION
DOCUMENTS SUBMISSION

CONTRACT No.

[illegible]

DRAWING TITLE

SITE EGRESS PLAN

SCALE $1/8"=1'-0"$

$$1/8'' = 1' - 0''$$

DRAWN BY

ISSUE DATE
ISSUED FOR BID 01/14/04

CHECKED

ARCH. JOB No. 9007

DRAWING TITLE

T-2-1

HHC PROJ. No.	IFA-741
CON No.	

FILE No.	H-8
No. OF SHEET	

NEW YORK CITY
HEALTH AND HOSPITALS
CORPORATION
125 WORTH STREET
NEW YORK, N.Y. 10013

HARLEM HOSPITAL CENTER
AMBULATORY CARE BUILDING
506 LENOX AVENUE
NEW YORK, N.Y. 10037

COLES/URS

Robert Traynham Coles, Architect, P.C.
URS Consultants, Inc.

A JOINT VENTURE
62 COOPER SQUARE - 11th FLOOR
NEW YORK, N.Y. 10003-7187


CIVIL ENGINEER
URS CONSULTANTS, INC.
ONE PENN PLAZA, SUITE 610
NEW YORK, NY 10119-0118

STRUCTURAL ENGINEER
URS CONSULTANTS, INC.
23355 MERCANTILE ROAD
CLEVELAND OHIO, 44122-4920


MECHANICAL/ELECTRICAL ENGINEER
HARDIE & ASSOCIATES
838 BROADWAY
NEW YORK, N.Y. 10003

CONSTRUCTION MANAGER
THACKER ENGINEERING, INC.
72 READE STREET - 3RD FLOOR
NEW YORK, N.Y. 10007

SITE KEY PLAN

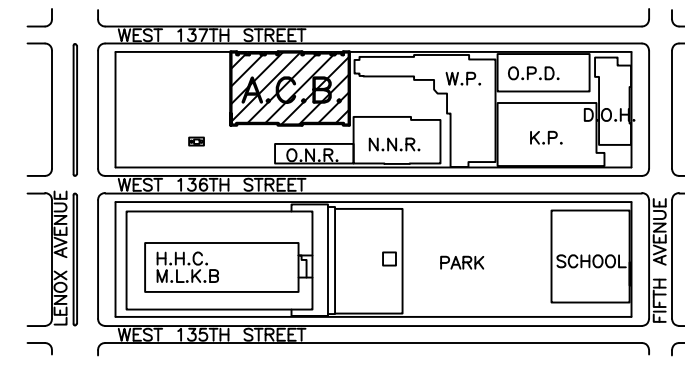

BUILDING KEY PLAN

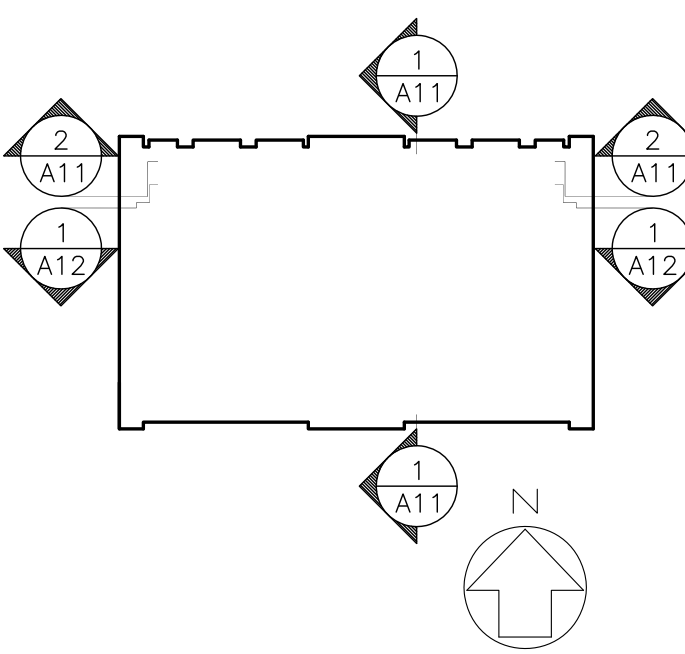

PROJECT

HARLEM HOSPITAL CENTER
AMBULATORY CARE BUILDING
CONSTRUCTION
DOCUMENTS SUBMISSION

CONTRACT No.

REVISIONS

REV#	DATE	DESCRIPTION	DWN	CKD
#1	9/12/2010	AS - BUILT		

DRAWING TITLE

OCCUPANT LOAD
CHARTS

SCALE 1/8"=1'-0"

DRAWN BY
CHECKED BY
ISSUE DATE
ISSUED FOR BID 01/14/94
ARCH. JOB No. 9007

DRAWING TITLE

T-4

HHC PROJ. No.
IFA-7419
CON No.

FILE No.
H-87
No. OF SHEETS

			Column 1		Coulmn 2		Coulmn 3
			Occupancy By area		Occupancy Actual		Greater of Actual vs. per Sq. Ft.
Area/Room	Sq. Ft.	No. of Rms.	Occ/ Rm.	Tot Occ.	Occ/Rm.	Tot Occ	Tot Occ
Pulic Areas							
Waiting-East	1,426	1	29	29	36	36	36
Library	244	1	3	3	4	4	4
Waiting-West	1,535	1	31	31	44	44	44
Lobby	1,309	1	27	27	21	21	27
Office 4130A	187	1	2	2	4	4	4
Bus office	610	1	6	6	14	14	14
Office in Lobby	80	1	1	1	2	2	2
Office off Waiting 4059	100	1	1	1	2	2	2
				100		127	133
Clinic/Staff Areas							
West clinic offices	105	13	1	13	2	26	26
West clinic exam	105	5	1	5	2	10	10
West Spec. Procedure-Lrg/Med	180	9	2	18	2	18	18
Conference 4008	170	1	2	2	8	8	8
Clerical 4011	170	1	2	2	2	2	2
Work 4032	75	1	1	1	1	1	1
Waiting 4042	150	1	2	2	5	5	5
Reception	77	2	1	2	2	4	4
Clean Utility	0						[*1] 0
Soiled Utility	1						[*1] 0
Storage/JC	1						[*1] 0
West Staff office reception	241	1	2	2	5	5	5
West Staff offices	95	5	1	5	2	10	10
Locker Rms	107	1	9	9	9	9	[*2] 9
West Staff office-large	150	1	2	2	2	2	2
						100	100
East clinic offices	105	15	1	15	2	30	30
East clinic exam	105	8	1	8	2	16	16
East clinic procedure rooms-L	200	0	2	0	2	0	0
East clinic procedure rooms-M	130	0	1	0	2	0	0
Reception	77	1	1	1	2	2	2
Workroom 4082	1022	1	10	10	22	22	22
Teaching 4083	425	1	4	4	16	16	16
Clean Utility	1						[*1] 0
Soiled Utility	1						[*1] 0
Storage-Files 4105	325	1	2	2	2	2	2
Storage/JC	3						[*1] 0
East Staff offices	125	4	1	4	2	8	8
East Staff office-large 3107	168	1	2	2	2	2	2
Secretarial 4103	220	1	2	2	4	4	4
Secretarial 4085	272	1	3	3	4	4	4
							106
Locker Rms	130	1	11	11	6	6	[*2] 11
Conference	388	1	4	4	10	10	[*2] 10
				129		122	21
							227
Total Occupant Load				229		349	360
Aggregate Stair Capacity limit for 3 stairs				360		360	360

			Column 1		Coulmn 2		Coulmn 3
			Occupancy By area		Occupancy Actual		Greater of Actual vs. per Sq. Ft.
Area/Room	Sq. Ft.	No. of Rms.	Occ/ Rm.	Tot Occ.	Occ/Rm.	Tot Occ	Tot Occ
Pulic Areas							
Waiting-East	1,712	1	35	35	51	51	51
Waiting-West	1,549	1	31	31	44	44	44
Lobby	1,184	1	24	24	21	21	24
Office 3134	187	1	2	2	4	4	4
Bus office	887	1	9	9	14	14	14
Office off Lobby	80	1	1	1	1	1	1
Office off Waiting 3019, 3040	100	2	1	2	2	4	4
				104		139	142
Clinic/Staff Areas							
West clinic offices	105	0	1	0	2	0	0
West clinic exam	105	26	1	26	2	52	52
West clinic procedure rooms	125	6	1	6	2	12	12
Reception	77	3	1	3	2	6	6
Clean Utility	1						[*1] 0
Soiled Utility	1						[*1] 0
Storage/JC	1						[*1] 0
West Staff office reception	547	1	5	5	5	5	5
West Staff offices	95	3	1	3	2	6	6
West Staff office-large	160	3	2	6	2	6	6
						87	87
East clinic offices	105	0	1	0	2	0	0
East clinic exam	105	26	1	26	2	52	52
East clinic procedure rooms-L	200	2	2	4	2	4	4
East clinic procedure rooms-M	130	4	1	4	2	8	8
Reception	77	3	1	3	2	6	6
Other	0		0	0	0	0	0
Conference	0		0	0	0	0	0
Clean Utility	1						[*1] 0
Soiled Utility	1						[*1] 0
Storage/JC	3						[*1] 0
East Staff offices	182	3	2	6	2	6	6
East Staff office-large 3107	348	1	3	3	3	3	3
East Staff conf. 3071	514	1	5	5	10	10	10
							89
Locker Rms	190	2	16	32	6	12	[*2] 32
Conference	388	1	4	4	10	10	[*2] 10
				136		111	42
							218
Total Occupant Load				240		337	360
Aggregate Stair Capacity limit for 3 stairs				360		360	360

			Column 1		Coulmn 2		Coulmn 3
			Occupancy By area		Occupancy Actual		Greater of Actual vs. per Sq. Ft.
Area/Room	Sq. Ft.	No. of Rms.	Occ/ Rm.	Tot Occ.	Occ/Rm.	Tot Occ	Tot Occ
Pulic Areas							
Waiting-East	2302	1	47	47	68	68	68
Waiting-West	2028	1	41	41	50	50	50
Lobby	1032	1	21	21	21	21	21
Office 2137	187	1	2	2	4	4	4
Bus office	887	1	9	9	14	14	14
Office off Lobby	80	1	1	1	1	1	1
Office off Waiting	100	2	1	2	2	4	4
				123		162	162
Clinic/Staff Areas							
West clinic offices	105	0	1	0	2	0	0
West clinic exam	105	19	1	19	2	38	38
West clinic procedure rooms	125	7	1	7	3	21	21
Reception	77	3	1	3	2	6	6
Clean Utility	1						[*1] 0
Soiled Utility	1						[*1] 0
Storage/JC	3						[*1] 0
West Staff offices	95	5	1	5	2	10	10
West Staff office-large	160	2	2	4	2	4	4
						79	79
East clinic offices	105	11	1	11	2	22	22
East clinic exam	105	10	1	10	2	20	20
East clinic procedure rooms-L	200	2	2	4	2	4	4
East clinic procedure rooms-M	130	1	1	1	2	2	2
Reception	77	3	1	3	2	6	6
Blood draw	80	1	1	1	2	2	2
Conference	200	1	2	2	6	6	6
Clean Utility	1						[*1] 0
Soiled Utility	2						[*1] 0
Storage/JC	4						[*1] 0
East Staff offices	95	4	1	4	2	8	8
East Staff office-large	180	2	2	4	2	4	4
Locker Rms	190	2	16	32	6	12	[*2] 32
Conference	388	1	4	4	10	10	[*2] 10
				114		96	116
Subtotal Staff and Clinic							195
Total Occupant Load				237		337	357

			Column 1		Coulmn 2		Coulmn 3
			Occupancy By area		Occupancy Actual		Greater of Actual vs. per Sq. Ft.
Area/Room	Sq. Ft.	No. of Rms.	Occ/ Rm.	Tot Occ.	Occ/Rm.	Tot Occ	Tot Occ
Pulic Areas							
Waiting-East	1,712	1	35	35	51	51	51
Waiting-West	1,549	1	31	31	44	44	44
Lobby	1,184	1	24	24	21	21	24
Office 3134	187	1	2	2	4	4	4
Bus office	887	1	9	9	14	14	14
Office off Lobby	80	1	1	1	1	1	1
Office off Waiting 3019, 3040	100	2	1	2	2	4	4
				104		139	142
Clinic/Staff Areas							
West clinic offices	105	0	1	0	2	0	0
West clinic exam	105	26	1	26	2	52	52
West clinic procedure rooms	125	6	1	6	2	12	12
Reception	77	3	1	3	2	6	6
Clean Utility	1						[*1] 0
Soiled Utility	1						[*1] 0
Storage/JC	1						[*1] 0
West Staff office reception	547	1	5	5	5	5	5
West Staff offices	95	3	1	3	2	6	6
West Staff office-large	160	3	2	6	2	6	6
						87	87
East clinic offices	105	0	1	0	2	0	0
East clinic exam	105	26	1	26	2	52	52
East clinic procedure rooms-L	200	2	2	4	2	4	4
East clinic procedure rooms-M	130	4	1	4	2	8	8
Reception	77	3	1	3	2	6	6
Other	0		0	0	0	0	0
Conference	0		0	0	0	0	0
Clean Utility	1						[*1] 0
Soiled Utility	1						[*1] 0
Storage/JC	3						[*1] 0
East Staff offices	182	3	2	6	2	6	6
East Staff office-large 3107	348	1	3	3	3	3	3
East Staff conf. 3071	514	1	5	5	10	10	10
							89
Locker Rms	190	2	16	32	6	12	[*2] 32
Conference	388	1	4	4	10	10	[*2] 10
				136		111	42
							218
Total Occupant Load				240		337	360
Aggregate Stair Capacity limit for 3 stairs				360		360	360

Cellar			Column 1		Coulmn 2		Coulmn 3	
			Occupancy By area		Occupancy Actual		Greater of Actual vs. per Sq. Ft.	
Area/Room	Sq. Ft.	No. of Rms.	Occ/ Rm.	Tot Occ.	Occ/Rm.	Tot Occ		Tot Occ
Clinic/Staff Areas								
Utility Rms B003, 04, 05, 06, 17	2088	1	10	10	1	5	[*2]	10
Locker Rms B007	455	1	38	38	6	6	[*2]	38
Storage Rm. B016	70	1	0.4	0.4	1	1	[*2]	1
Elev. Mach. Rms. B010, 15	238	2	1.2	2.4	1	2	[*2]	2
Storage Rms. B014	326	1	2	2	2	2	[*2]	2
Telecommunications B018	164	1	1	1	1	1	[*2]	1
Data B018	498	1	2.5	2.5	3	3	[*2]	3
Total Occupant Load				56	20		57	
Aggregate Stair Capacity of two (2) stairs			240		240		240	

HARLEM HOSPITAL CENTER
AMBULATORY CARE BUILDING
506 LENOX AVENUE
NEW YORK, N.Y. 10037

A JOINT VENTURE
62 COOPER SQUARE - 11
NEW YORK, N.Y. 10003

URS CONSULTANTS, INC.
ONE PENN PLAZA, SUITE 610
NEW YORK, NY 10119-0118

URS CONSULTANTS, INC.
23355 MERCANTILE ROAD
CLEVELAND OHIO, 44122-4920

HARDIE & ASSOCIATES
838 BROADWAY
NEW YORK, N.Y. 10003

CONSTRUCTION MANAGER
THACKER ENGINEERING, INC.
72 READE STREET - 3RD FLOOR
NEW YORK, N.Y. 10007

HARLEM HOSPITAL CENTER
AMBULATORY CARE BUILDING
CONSTRUCTION
DOCUMENTS SUBMISSION

[illegible]

CELLAR
EGRESS PLAN


DRAWN BY	ISSUE DATE
----------	------------

CHECKED BY	ARCH. JOB No. 9007
------------	--------------------

T-4-C

HHC PROJ. No.	IFA-7419
CON No.	

FILE No.	H-87
No. OF SHEETS	

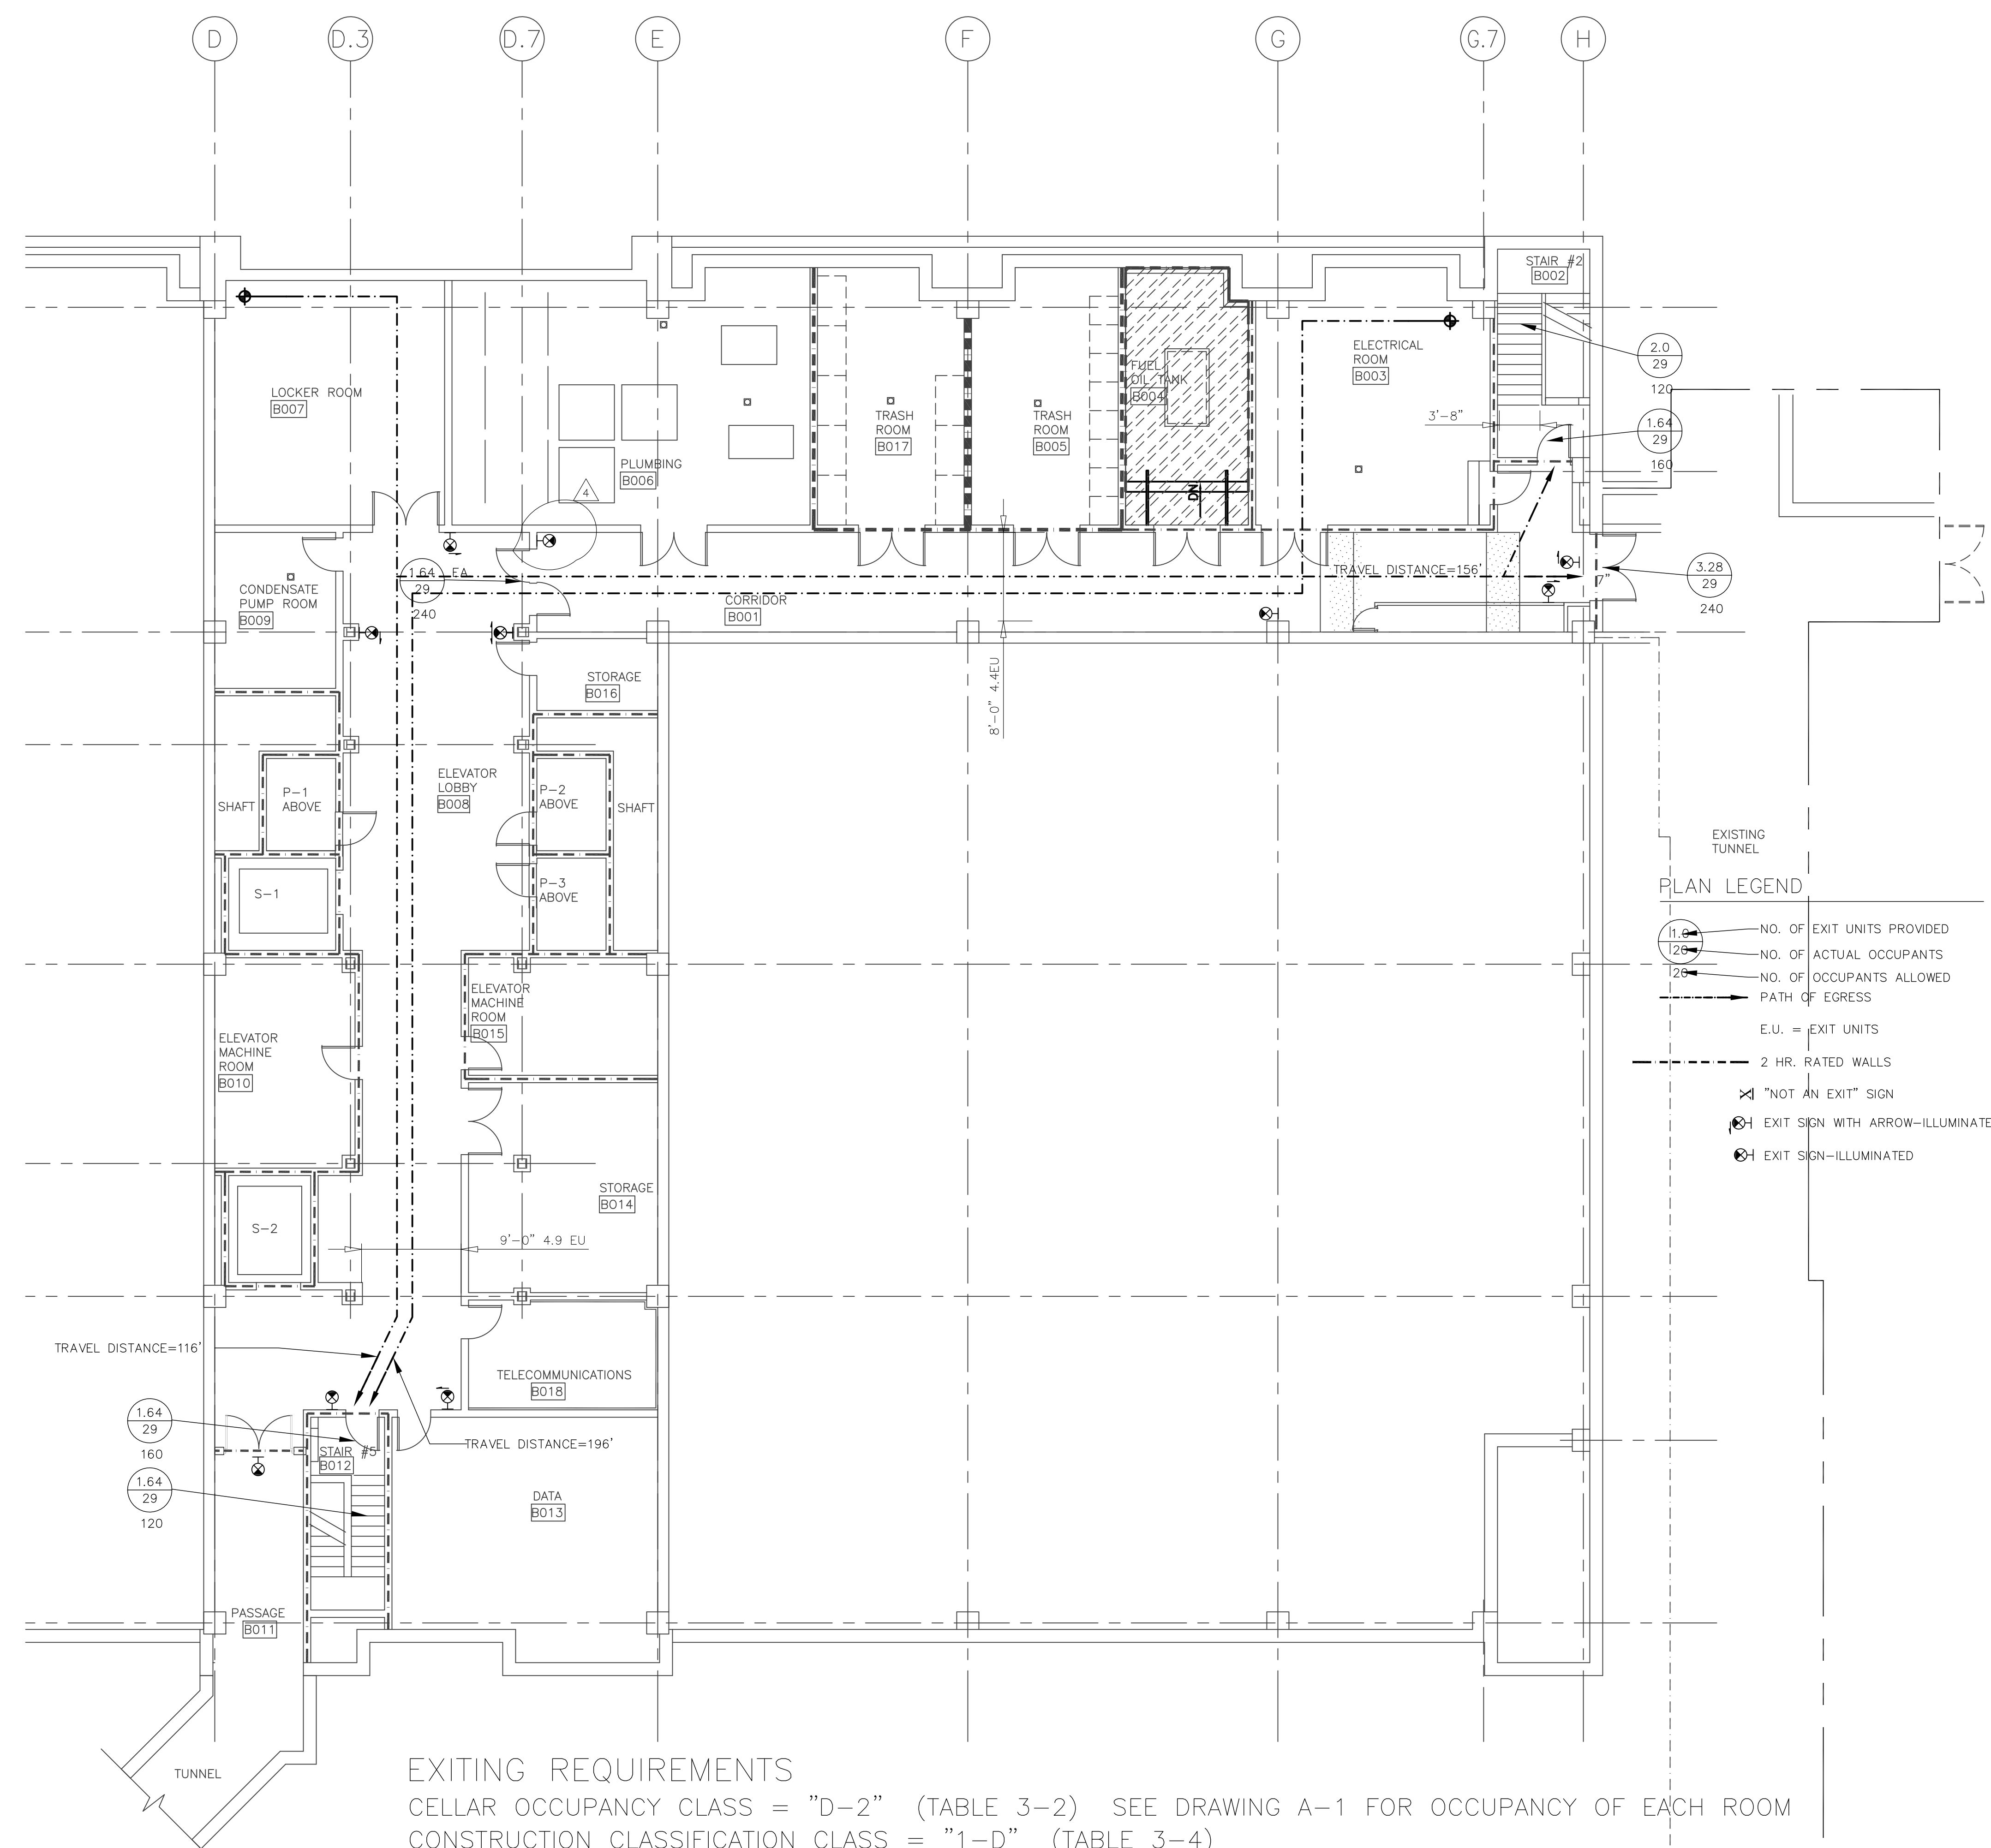

CELLAR OCCUPANCY CLASS = "D-2" (TABLE 3-2) SEE DRAWING A-1 FOR OCCUPANCY OF EACH ROOM
CONSTRUCTION CLASSIFICATION CLASS = "1-D" (TABLE 3-4)

MAX. TRAVEL DISTANCE TO AN EXIT = 200' PRIMARY (TABLE 6-1, "D=2"-SPRINKLERED)

MAX. DEAD END CORRIDOR = 50' (27-359)

OF PERSONS / UNIT OF 22" EXIT WIDTH: (27-3)

STAIRS = 60 PERSONS

HORIZONTAL EXITS = 100

NO. OF EXITS REQUIRED = 2 MIN. (27-366)

OCCUPANT LOAD (CLASS D-2) = 200 S.F. PER PERSON (TABLE 6-2 INDUSTRIAL)

NET AREA THIS FLOOR. OCCUPANT LOAD: 57 PERSONS, SEE OCCUPANT LOAD TABLE FOR DETAILS.

COLES/URS

Robert Traynham Coles, Architect, P.C.
URS Consultants, Inc.

A JOINT VENTURE
62 COOPER SQUARE - 11th FLOOR
NEW YORK, N.Y. 10003-7187

CIVIL ENGINEER

URS CONSULTANTS, INC.
ONE PENN PLAZA, SUITE 610
NEW YORK, NY 10119-0118

STRUCTURAL ENGINEER

URS CONSULTANTS, INC.
23355 MERCANTILE ROAD
CLEVELAND OHIO, 44122-4920


MECHANICAL/ELECTRICAL ENGINEER

HARDIE & ASSOCIATES
838 BROADWAY
NEW YORK, N.Y. 10003


CONSTRUCTION MANAGER

THACKER ENGINEERING, INC.
72 READE STREET - 3RD FLOOR
NEW YORK, N.Y. 10007

SITE KEY PLAN

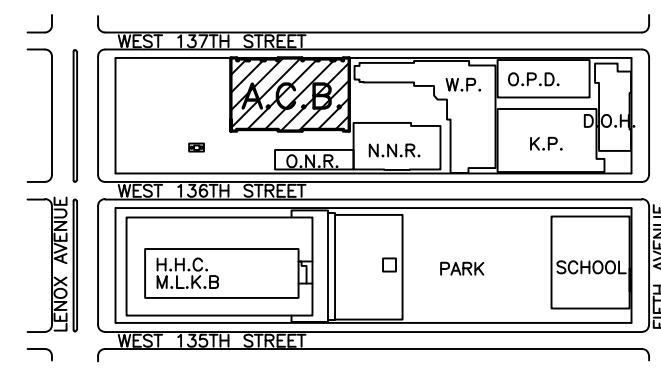

BUILDING KEY PLAN

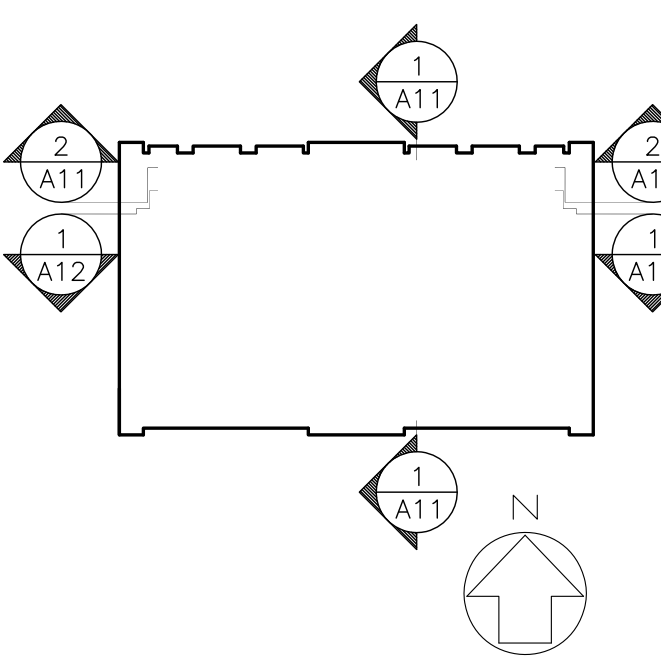

PROJECT

HARLEM HOSPITAL CENTER
AMBULATORY CARE BUILDING
CONSTRUCTION
DOCUMENTS SUBMISSION

CONTRACT No.

REVISIONS

REV#	DATE	DESCRIPTION	DWN	CKD
#1	5/31/94	NYC DOB REVIEW		
#2	7/8/94	DOB REV.-EG. UNITS		
#3	6/27/2010	AS - BUILT		
#4	7/6/2011	AS-BUILT -EXIT SIGNS, LOCK		


DRAWING TITLE

FOURTH FLOOR
EGRESS PLAN

SCALE 1/8"=1'-0"

DRAWN BY	ISSUE DATE
CHECKED BY	ISSUED FOR BID 01/14/94
	ARCH. JOB No. 9007

DRAWING TITLE	T-3-4
HHC PROJ. No. IFA-7419	FILE No. H-87
CON No.	No. OF SHEETS

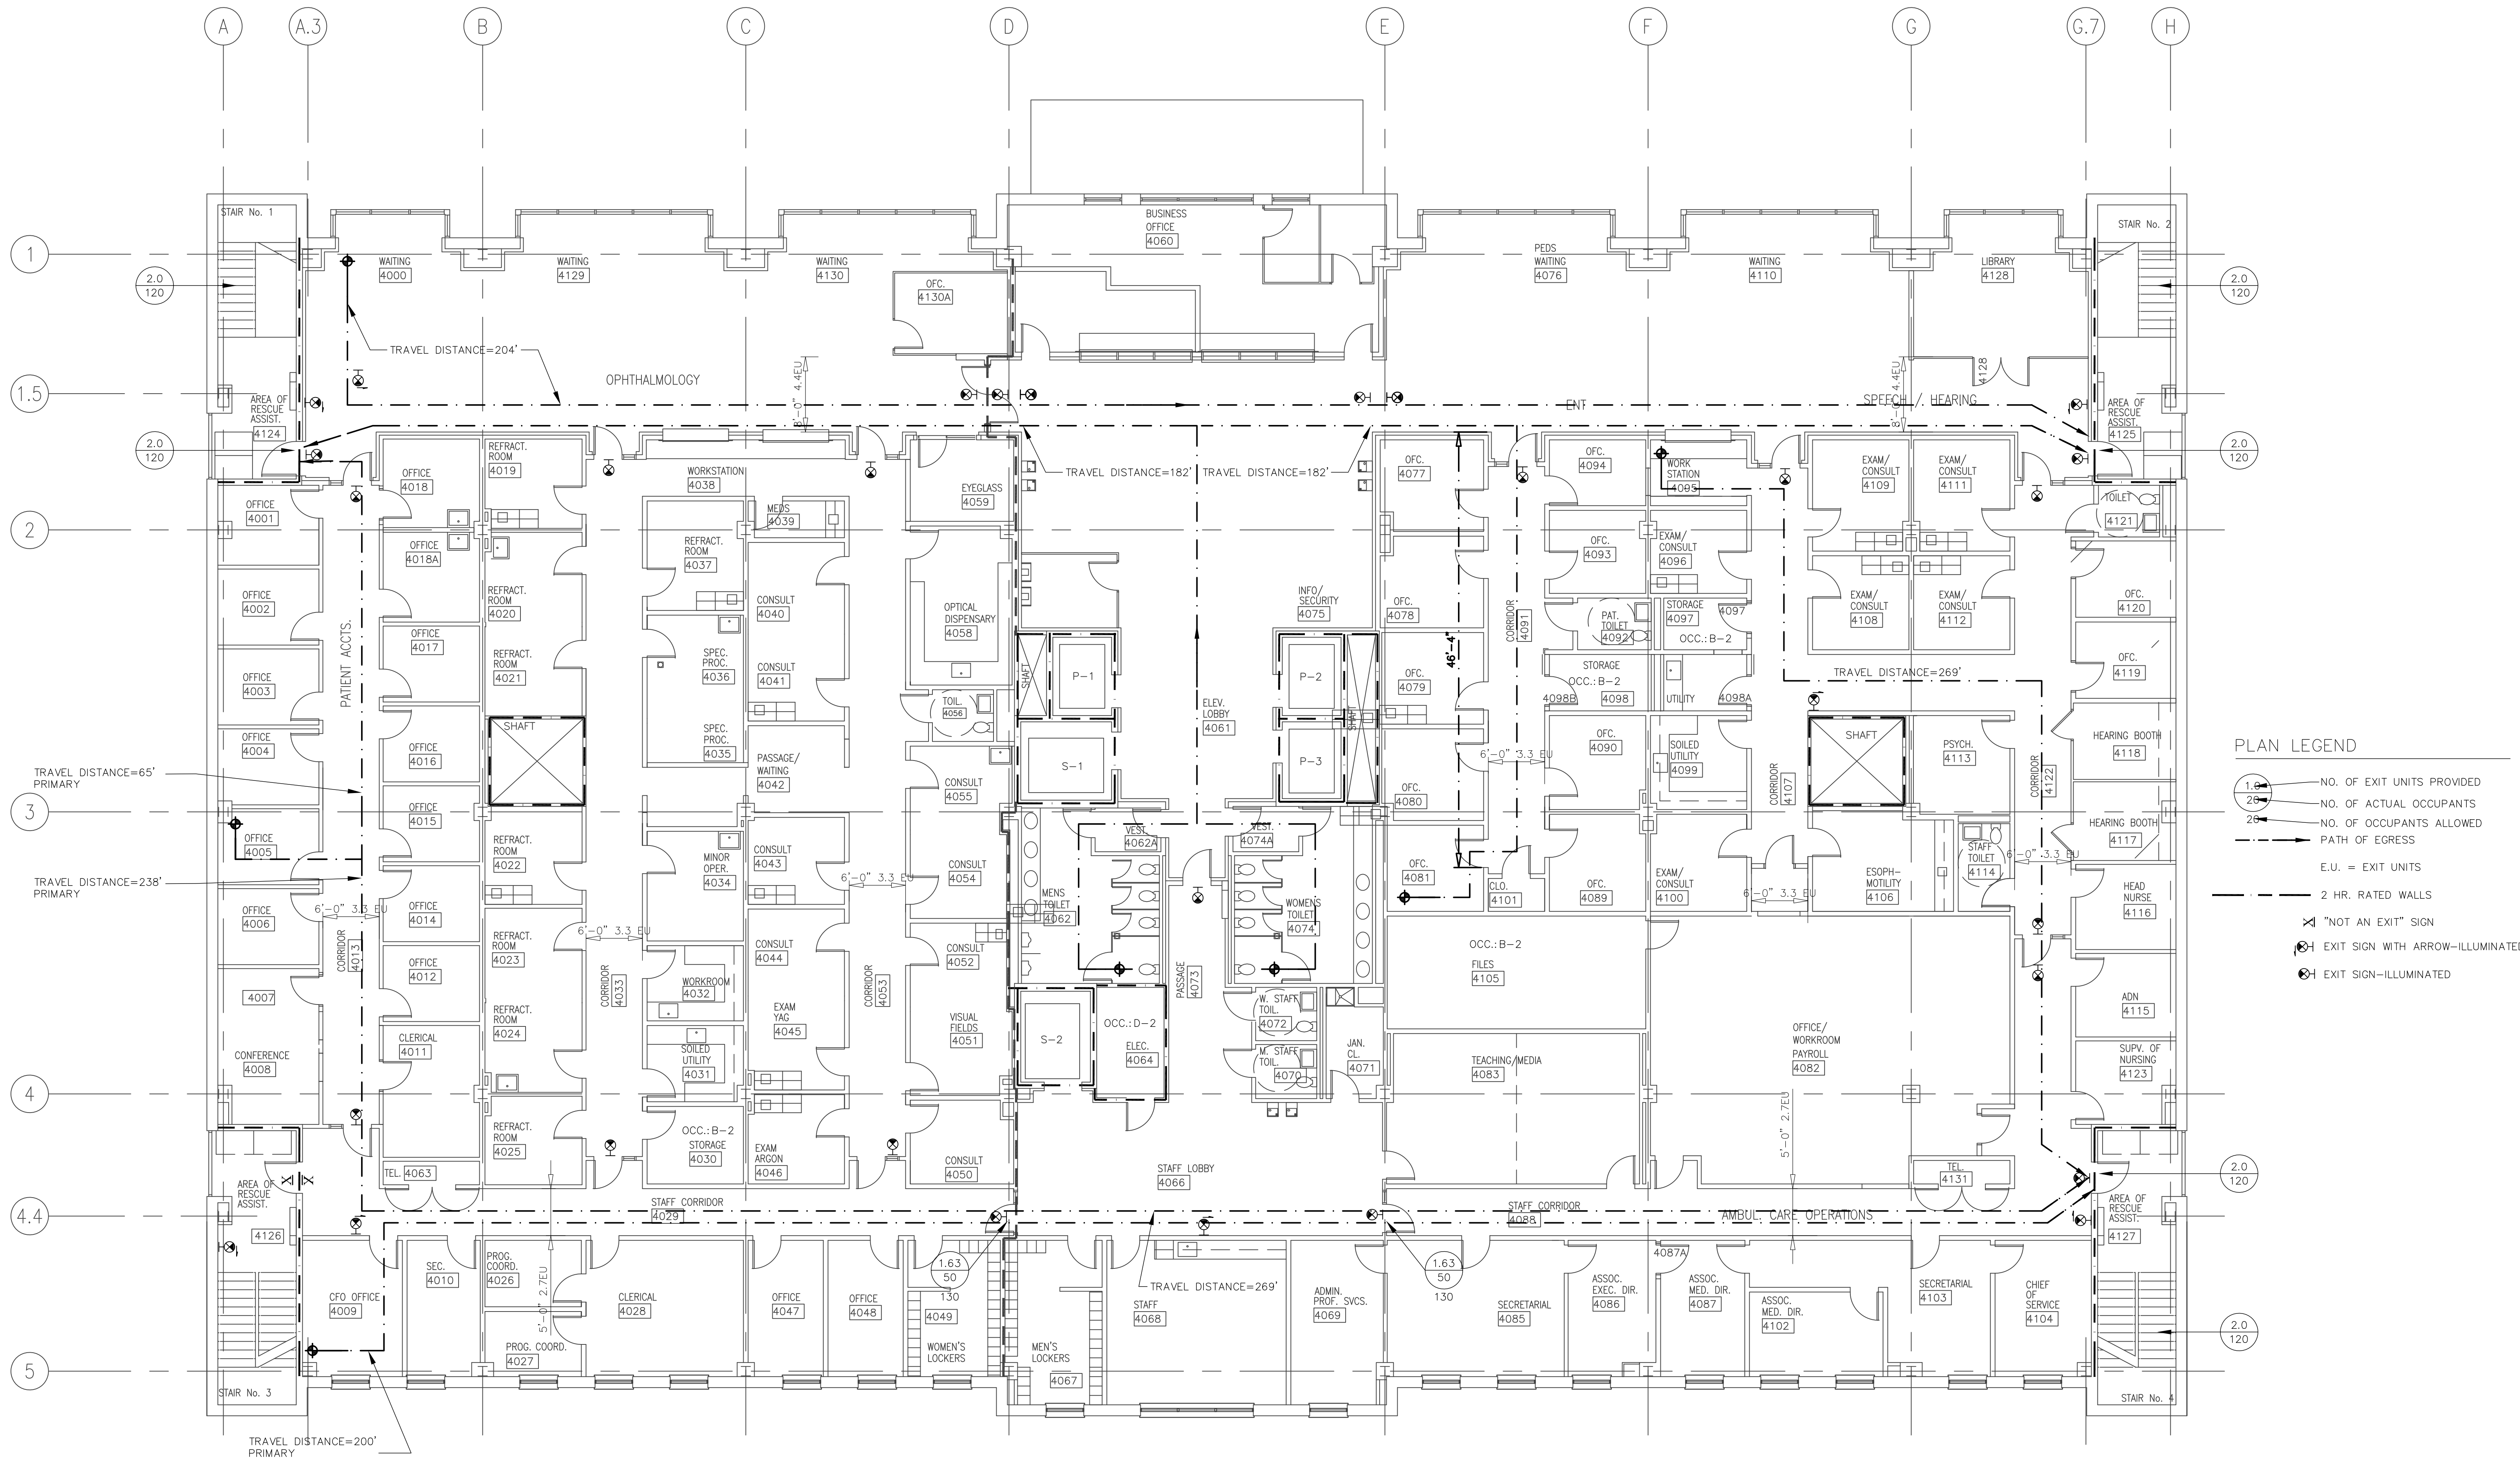

EXITING REQUIREMENTS (SEE 1st FLOOR PLAN)
FOURTH FLOOR OCCUPANT LOAD
LOBBY/WAITING AREA =227 PERSONS
STAFF/CLINIC AREA =133 PERSONS
TOTAL =360 PERSONS

NOTE: UNLESS OTHERWISE NOTED, ALL ROOMS
ARE "E" OCCUPANCY

COLES/URS

Robert Traynham Coles, Architect, P.C.
URS Consultants, Inc.

A JOINT VENTURE
62 COOPER SQUARE - 11th FLOOR
NEW YORK, N.Y. 10003-7187

CIVIL ENGINEER

URS CONSULTANTS, INC.
ONE PENN PLAZA, SUITE 610
NEW YORK, NY 10119-0118

STRUCTURAL ENGINEER

URS CONSULTANTS, INC.
23355 MERCANTILE ROAD
CLEVELAND OHIO, 44122-4920


MECHANICAL/ELECTRICAL ENGINEER

HARDIE & ASSOCIATES
838 BROADWAY
NEW YORK, N.Y. 10003


CONSTRUCTION MANAGER

THACKER ENGINEERING, INC.
72 READE STREET - 3RD FLOOR
NEW YORK, N.Y. 10007

SITE KEY PLAN

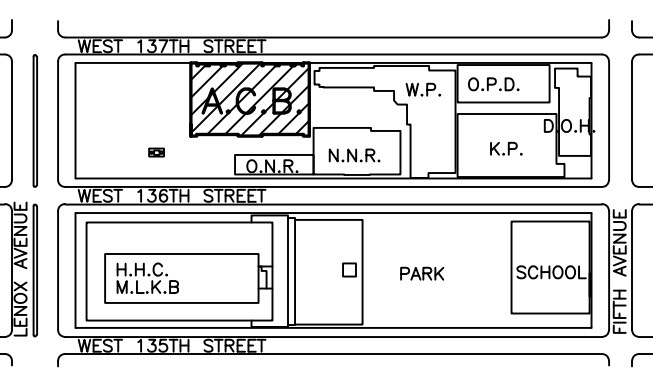

BUILDING KEY PLAN

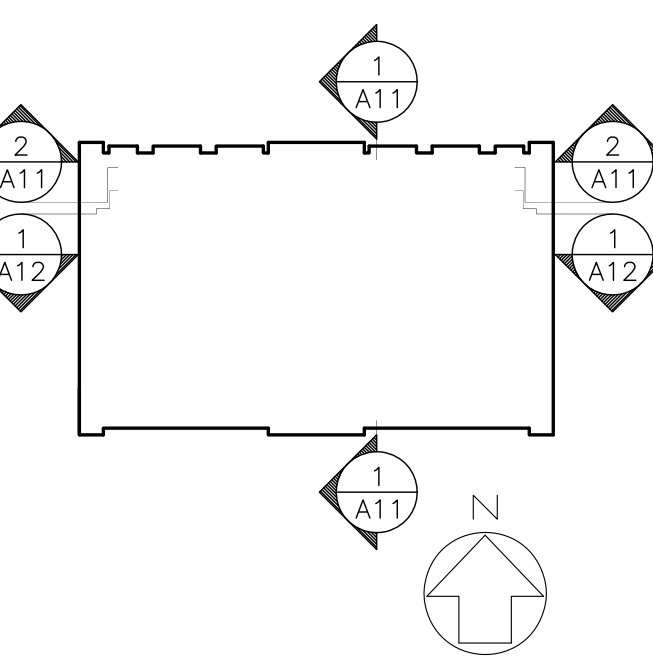

PROJECT

HARLEM HOSPITAL CENTER
AMBULATORY CARE BUILDING
CONSTRUCTION
DOCUMENTS SUBMISSION

CONTRACT No.

REVISIONS

REV#	DATE	DESCRIPTION	DWN	CKD
#1	5/31/94	NYC DOB REVIEW		
#2	7/8/94	DOB REV.-EG. UNITS		
#3	6/27/2010	AS - BUILT		
#4	7/6/2011	AS-BUILT -EXIT SIGNS		

DRAWING TITLE

THIRD FLOOR
EGRESS PLAN

SCALE

1/8"=1'-0"

DRAWN BY

ISSUE DATE
ISSUED FOR BID 01/14/94

CHECKED BY

ARCH. JOB No. 9007

DRAWING TITLE


T-3-3

HHC PROJ. No.

FILE No. H-87

CON No.

No. OF SHEETS

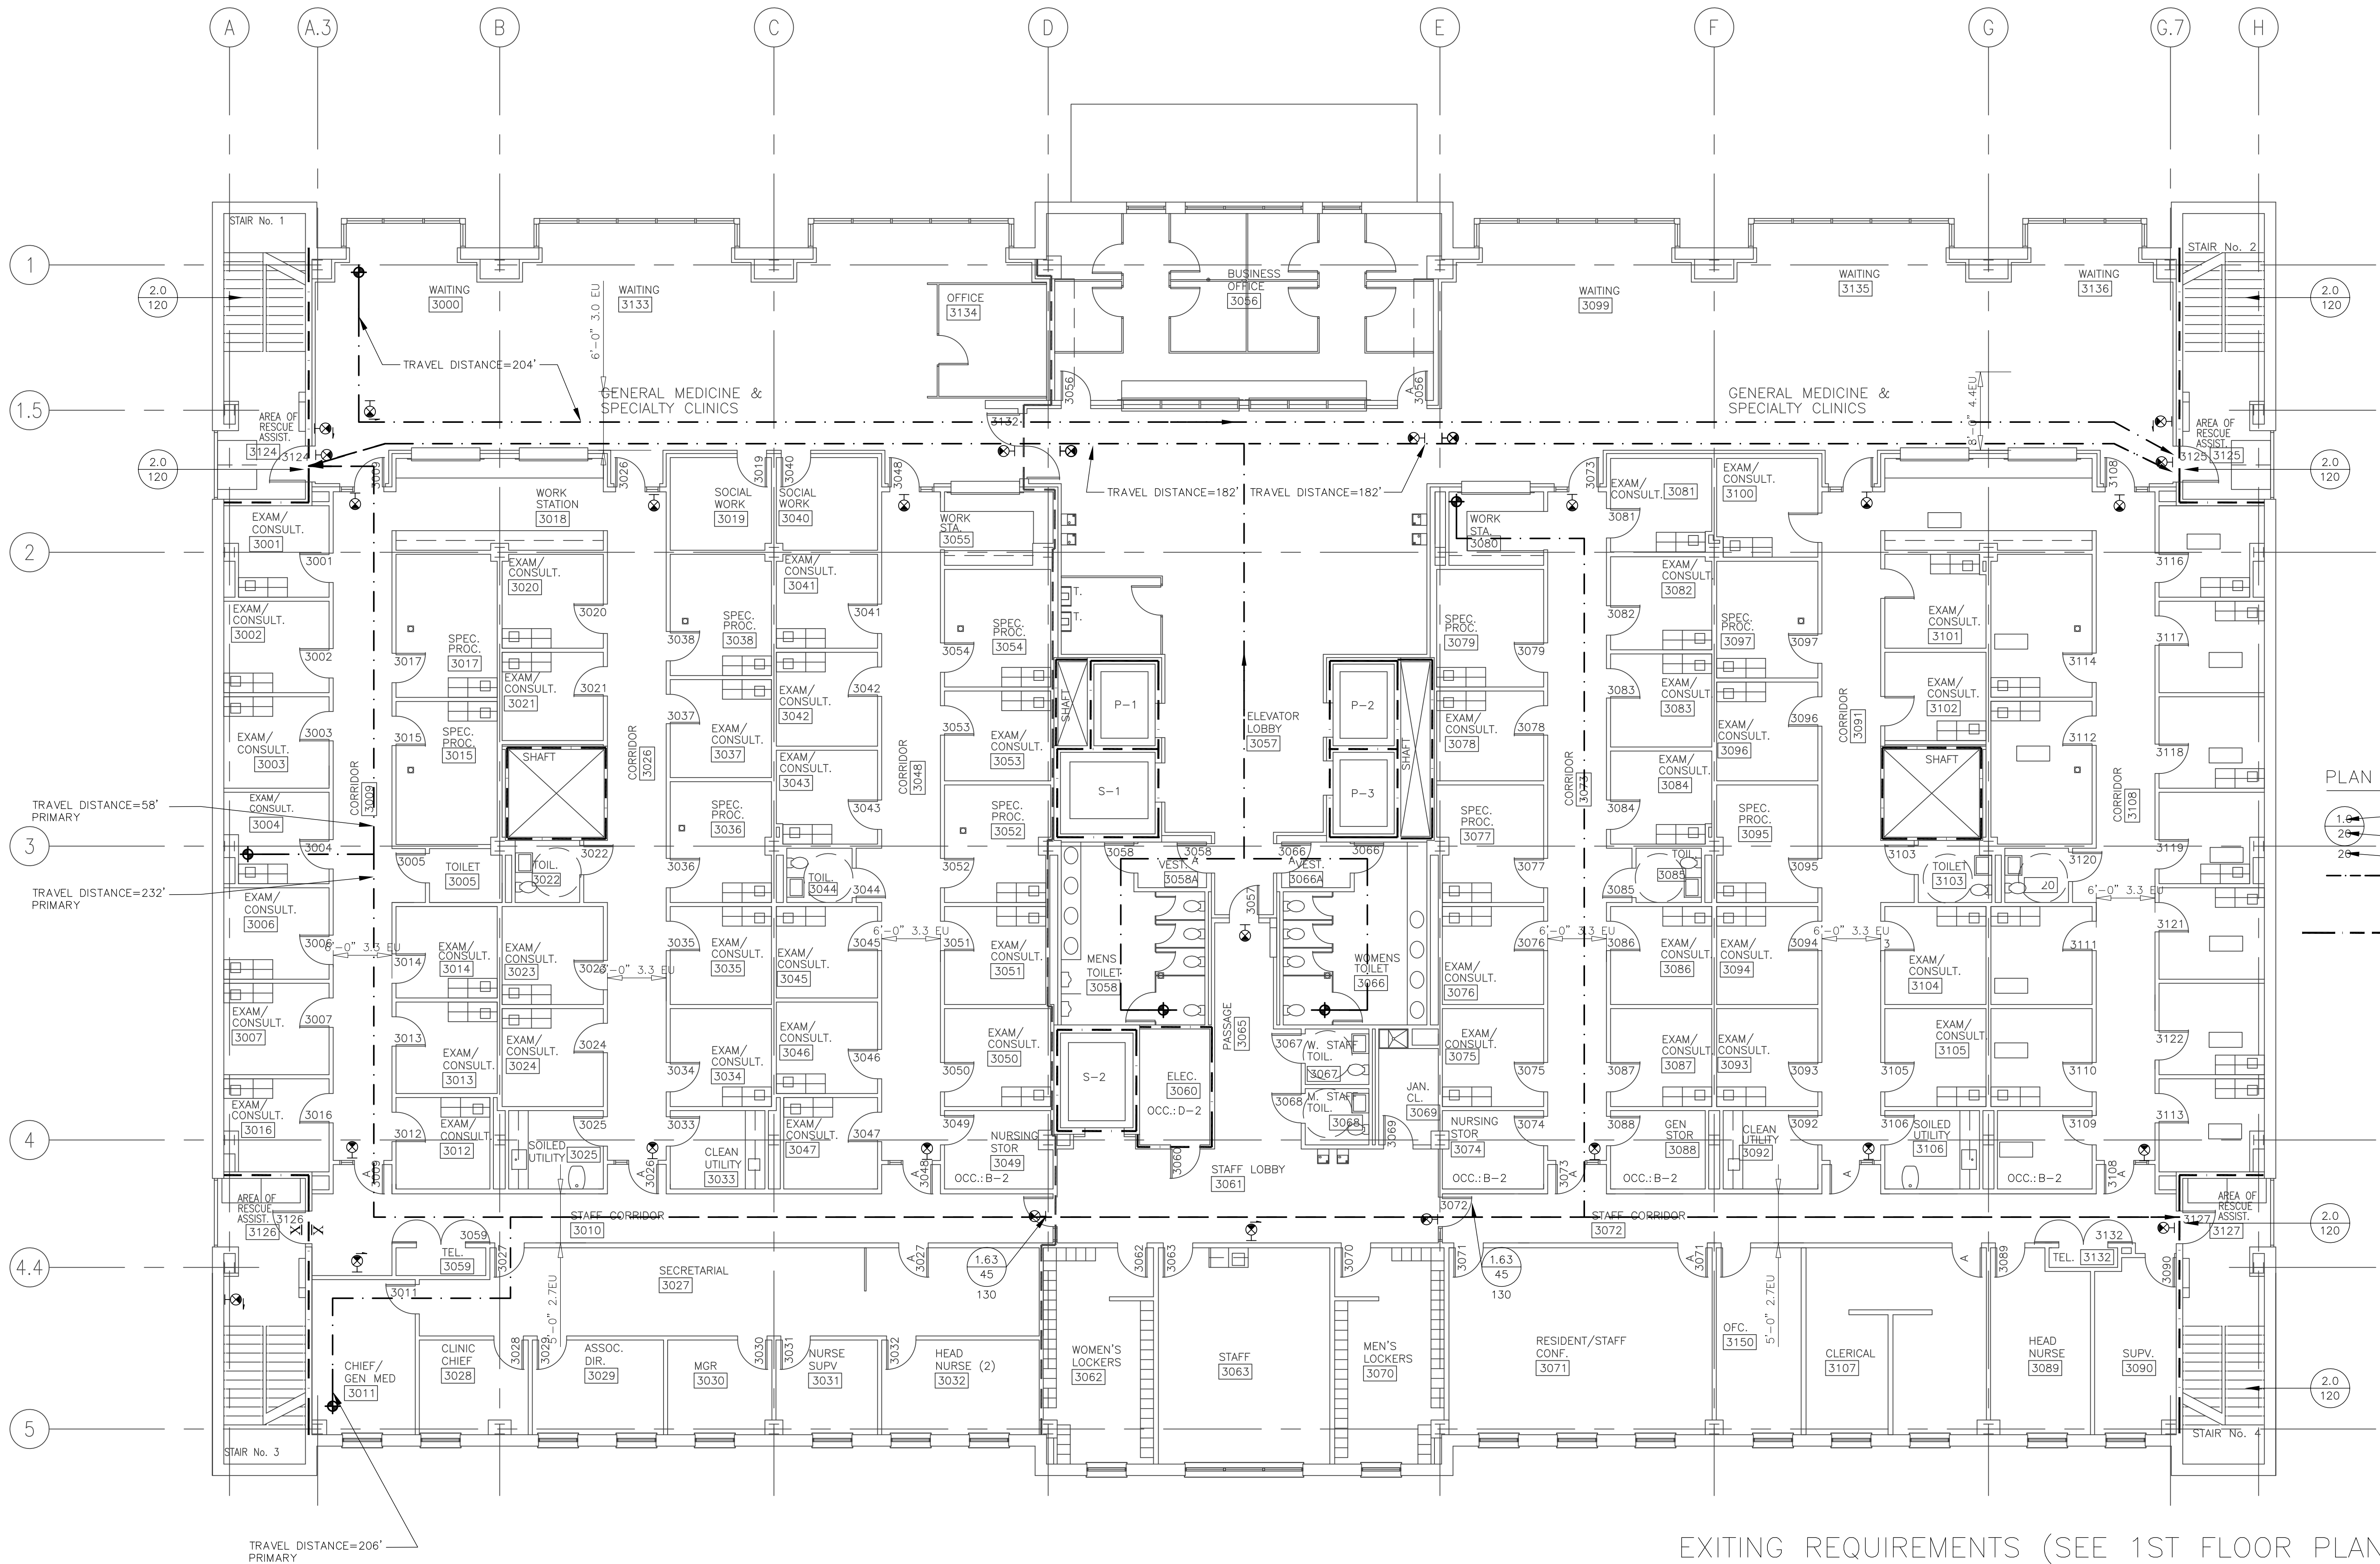

EXITING REQUIREMENTS (SEE 1ST FLOOR PLAN)

THIRD FLOOR OCCUPANT LOAD

LOBBY/WAITING AREA =142 PERSONS
STAFF/CLINIC AREA =218 PERSONS
TOTAL =360 PERSONS

SEE OCCUPANT LOAD CHART FOR DETAILED OCCUPANT LOADS

NOTE: UNLESS OTHERWISE NOTED, ALL ROOMS ARE "E" OCCUPANCY

NEW YORK CITY
HEALTH AND HOSPITALS
CORPORATION
125 WORTH STREET
NEW YORK, N.Y. 10013

HARLEM HOSPITAL CENTER
AMBULATORY CARE BUILDING
506 LENOX AVENUE
NEW YORK, N.Y. 10037

COLES/URS

Robert Traynham Coles, Architect, P.C.
URS Consultants, Inc.

A JOINT VENTURE
62 COOPER SQUARE - 11th FLOOR
NEW YORK, N.Y. 10003-7187

CIVIL ENGINEER

URS CONSULTANTS, INC.
ONE PENN PLAZA, SUITE 610
NEW YORK, NY 10119-0118

STRUCTURAL ENGINEER

URS CONSULTANTS, INC.
23355 MERCANTILE ROAD
CLEVELAND OHIO, 44122-4920


MECHANICAL/ELECTRICAL ENGINEER

HARDIE & ASSOCIATES
838 BROADWAY
NEW YORK, N.Y. 10003


CONSTRUCTION MANAGER

THACKER ENGINEERING, INC.
72 READE STREET - 3RD FLOOR
NEW YORK, N.Y. 10007

SITE KEY PLAN

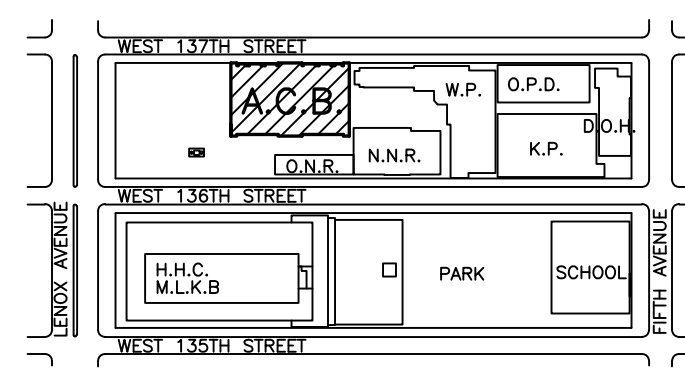

BUILDING KEY PLAN

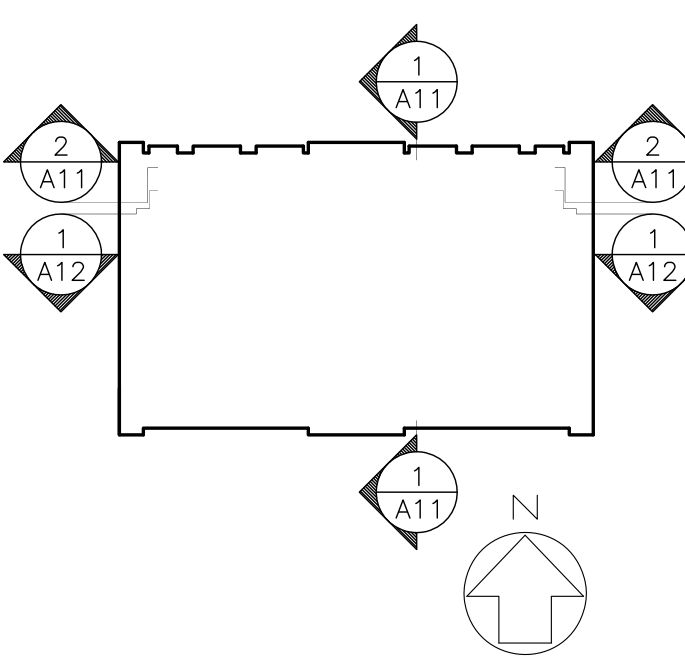

PROJECT

HARLEM HOSPITAL CENTER
AMBULATORY CARE BUILDING
CONSTRUCTION
DOCUMENTS SUBMISSION

CONTRACT No.

REVISIONS

REV#	DATE	DESCRIPTION	DWN	CKD
#1	5/31/94	NYC DOB REVIEW		
#2	7/8/94	DOB REV.-EG. UNITS		
#3	3/01/2010	AS - BUILT		
#4	6/12/2010	EGRESS		
#5	7/6/2011	AS-BUILT -EXIT SIGNS		

DRAWING TITLE

SECOND FLOOR
EGRESS PLAN

SCALE

1/8"=1'-0"

DRAWN BY

ISSUE DATE

CHECKED BY


ARCH. JOB No. 9007

DRAWING TITLE

T-3-2

HHC PROJ. No.
IFA-7419
CON No.

FILE No.
H-87
No. OF SHEETS

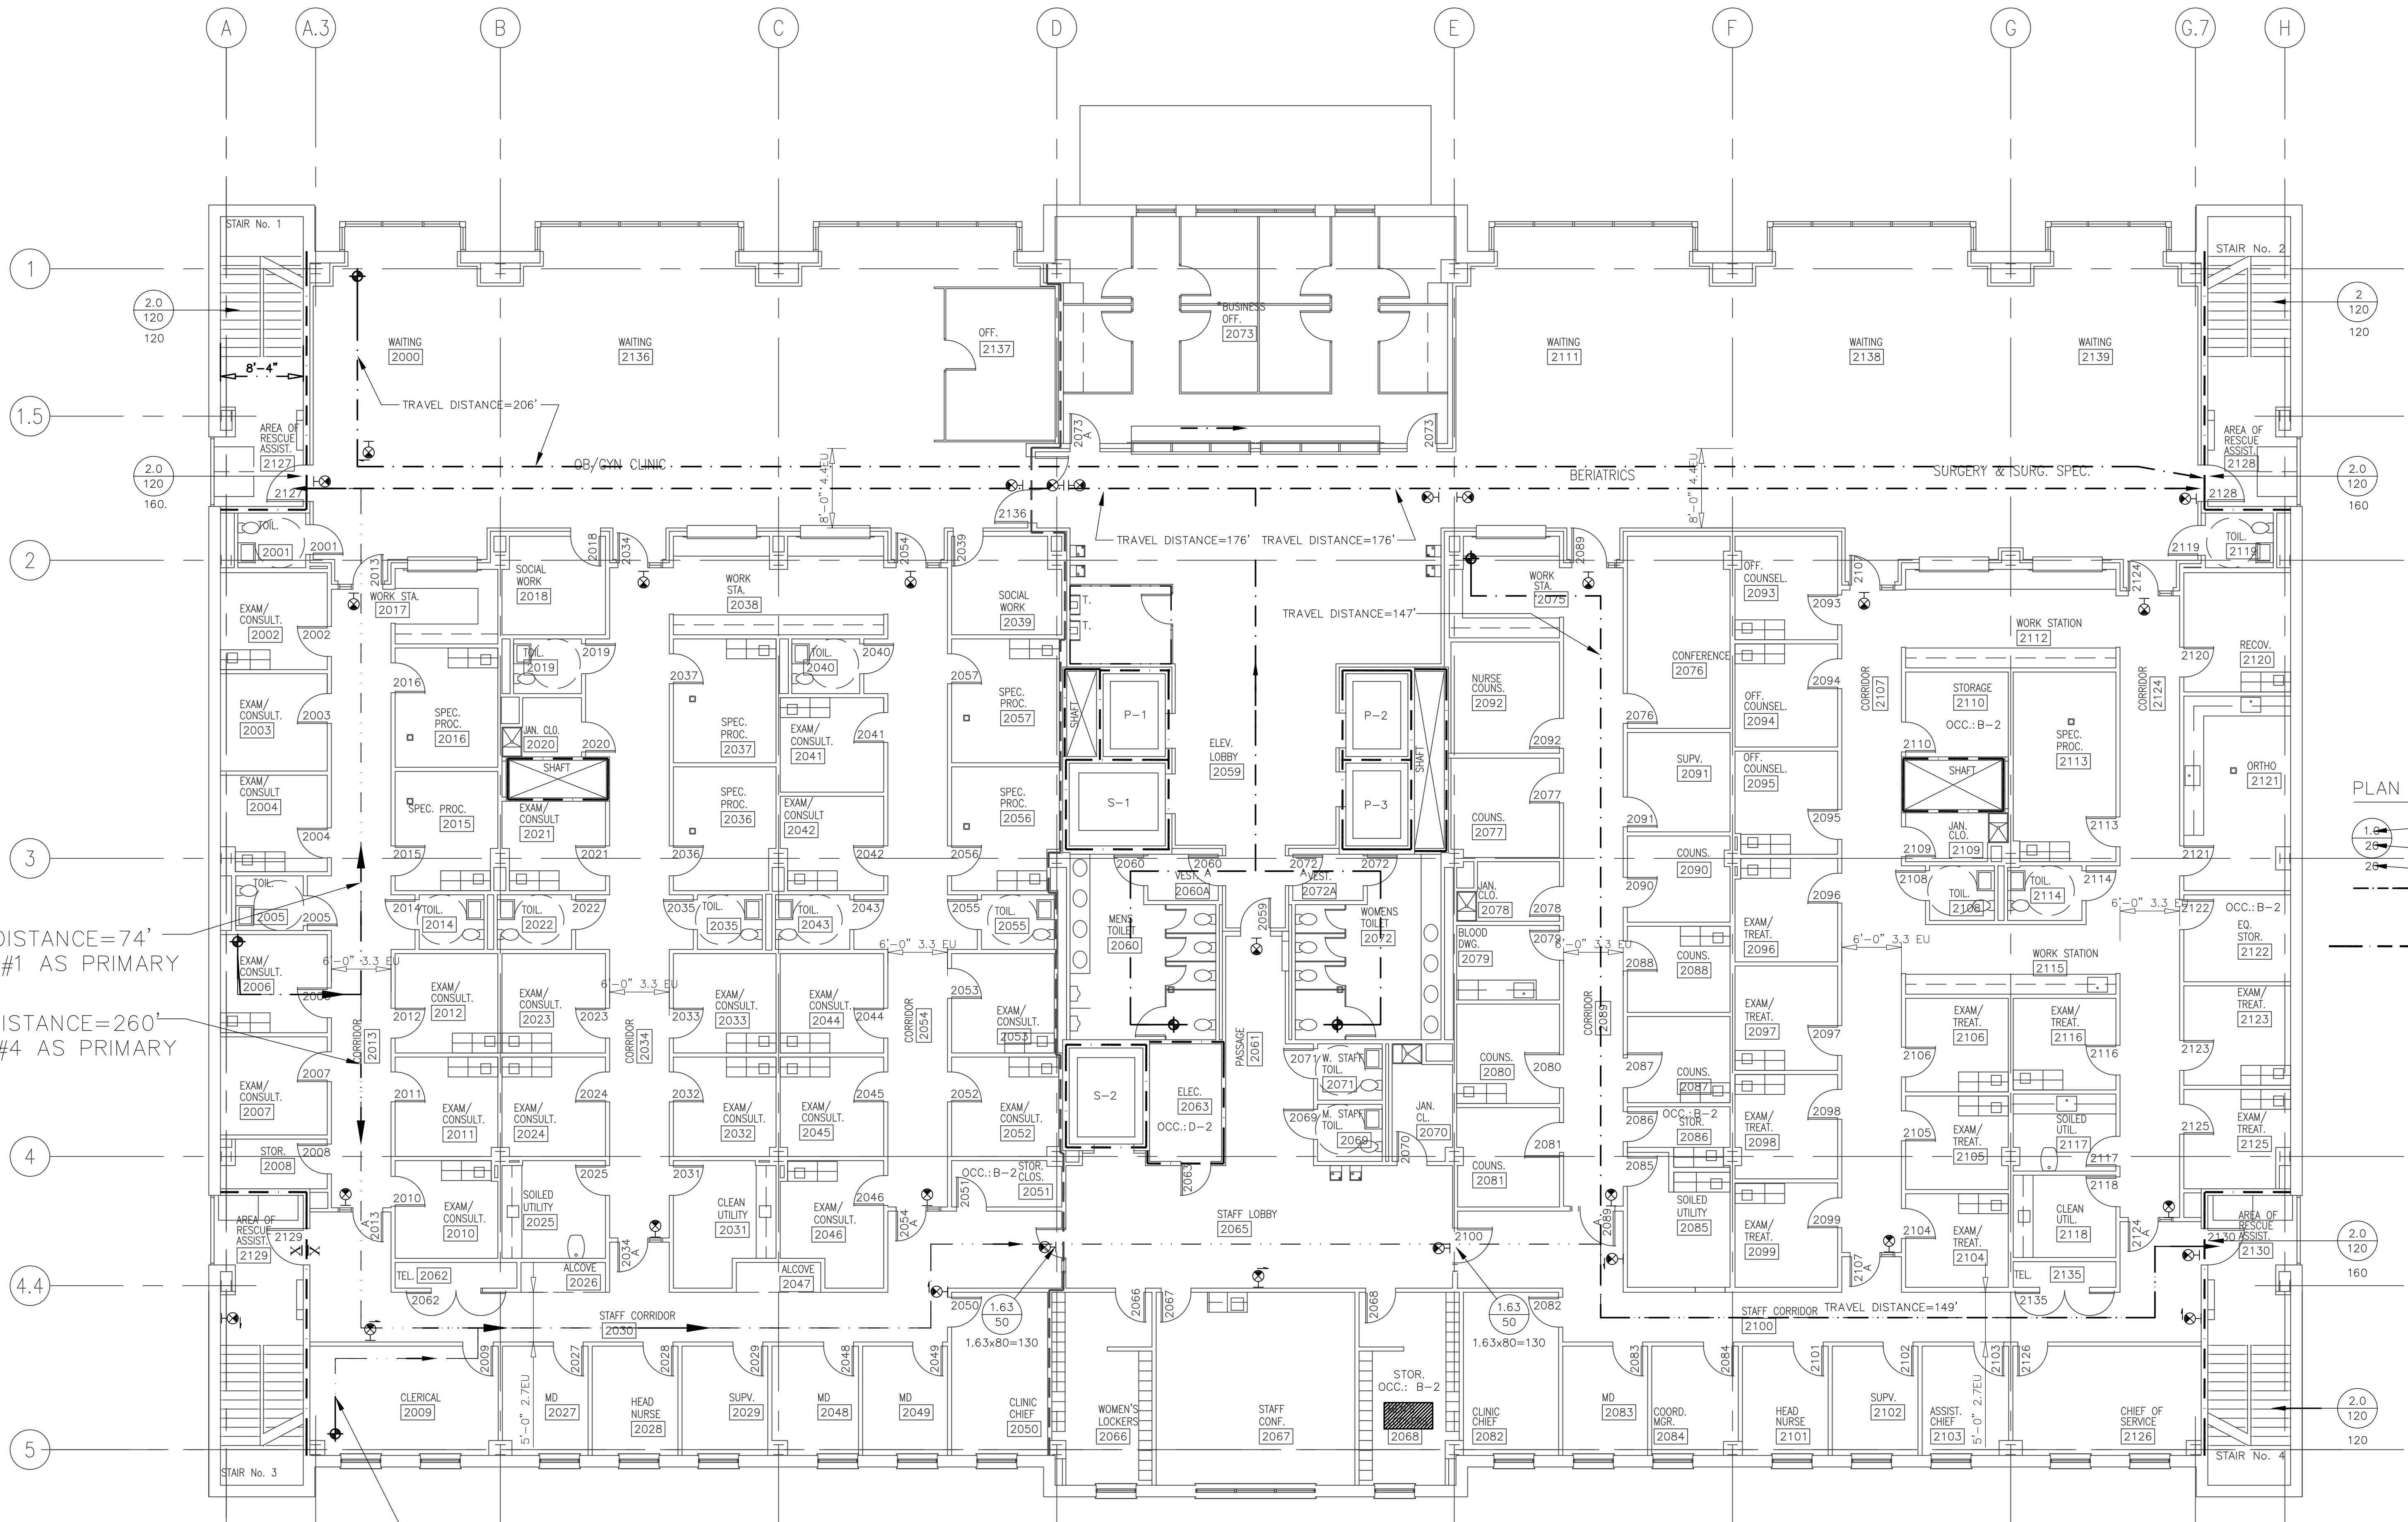

PLAN LEGEND

- 1.0 NO. OF EXIT UNITS PROVIDED
- 2.0 NO. OF ACTUAL OCCUPANTS
- 2.0 NO. OF OCCUPANTS ALLOWED
- PATH OF EGRESS
- E.U. = EXIT UNITS
- 2 HR. RATED WALLS
- NOT AN EXIT SIGN
- EXIT SIGN WITH ARROW-ILLUMINATED
- EXIT SIGN-ILLUMINATED

TRAVEL DISTANCE=74'
TO STR. #1 AS PRIMARY

TRAVEL DISTANCE=260'
TO STR. #4 AS PRIMARY

TRAVEL DISTANCE=221'
TO STR. #4 AS PRIMARY.
TRAVEL DISTANCE=279'
TO STR. #1 AS PRIMARY

EXITING REQUIREMENTS

1ST THRU 4TH FLOOR OCCUPANCY CLASS = "E" (TABLE 3-2)

CONSTRUCTION CLASSIFICATION CLASS = "1-D" (TABLE 3-4)

- MAX. TRAVEL DISTANCE TO AN EXIT = 300' PRIMARY (TABLE 6-1, "E" SPRINKLERED)
- MAX. TRAVEL DISTANCE TO AN EXIT = 300' SECONDARY (TABLE 6-1, "E" SPRINKLERED)
- MAX. DEAD END CORRIDOR = 50' (27-359)
- NO. OF PERSONS / UNIT OF 22" EXIT WIDTH: (27-359)
- GRADE LEVEL EXIT DOORS = 100 PERSONS
- ALL OTHER DOORS = 80 PERSONS
- STAIRS = 60 PERSONS
- HORIZONTAL EXITS = 100 PERSONS

SECOND FLOOR OCCUPANT LOAD

LOBBY/WAITING AREA =162 PERSONS
STAFF/CLINIC AREA =195 PERSONS
TOTAL =357 PERSONS

SEE OCCUPANT LOAD CHART FOR DETAILED OCCUPANT LOADS

NOTE: UNLESS OTHERWISE NOTED, ALL ROOMS ARE "E"
OCCUPANCY

NEW YORK CITY
HEALTH AND HOSPITALS
CORPORATION
125 WORTH STREET
NEW YORK, N.Y. 10013

HARLEM HOSPITAL CENTER
AMBULATORY CARE BUILDING
506 LENOX AVENUE
NEW YORK, N.Y. 10037

COLES/URS

Robert Traynham Coles, Architect, P.C.
URS Consultants, Inc.

A JOINT VENTURE

62 COOPER SQUARE - 11th FLOOR
NEW YORK, N.Y. 10003-7187

CIVIL ENGINEER

URS CONSULTANTS, INC.
ONE PENN PLAZA, SUITE 610
NEW YORK, NY 10119-0118

STRUCTURAL ENGINEER

URS CONSULTANTS, INC.
23355 MERCANTILE ROAD
CLEVELAND, OHIO, 44122-4920


MECHANICAL/ELECTRICAL ENGINEER

HARDIE & ASSOCIATES
838 BROADWAY
NEW YORK, N.Y. 10003


CONSTRUCTION MANAGER

THACKER ENGINEERING, INC.
72 READE STREET - 3RD FLOOR
NEW YORK, N.Y. 10007

SITE KEY PLAN

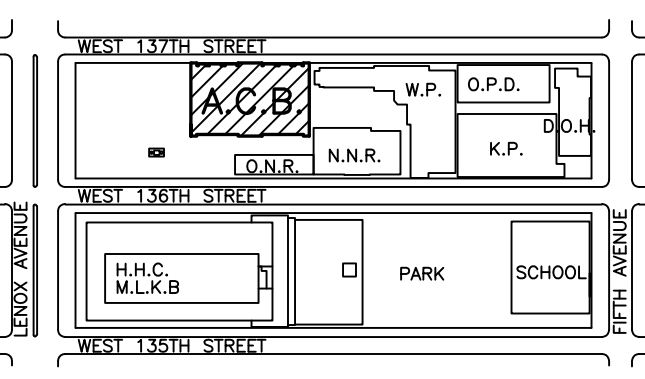

BUILDING KEY PLAN

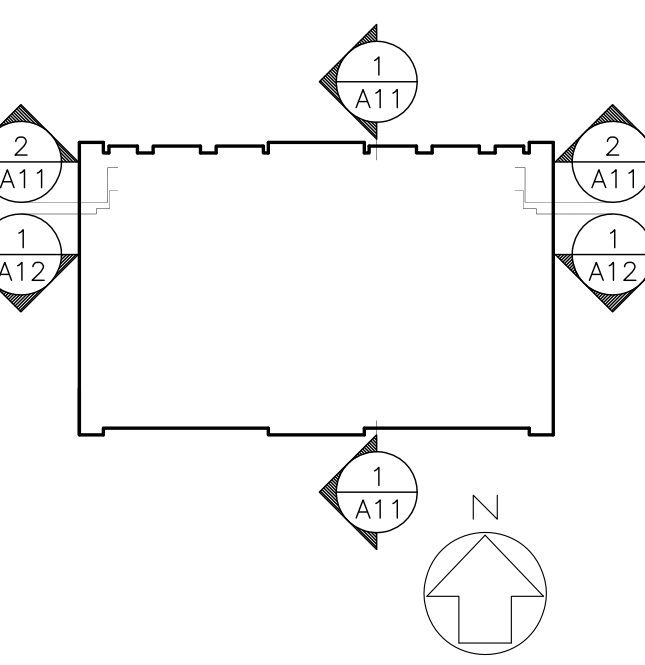

PROJECT

HARLEM HOSPITAL CENTER
AMBULATORY CARE BUILDING
CONSTRUCTION
DOCUMENTS SUBMISSION

CONTRACT No.

REVISIONS

REV#	DATE	DESCRIPTION	DWN	CKD
#1	5/31/94	NYC DOB REVIEW		
#2	7/8/94	DOB REV.-EG. UNITS		
#3	6/27/2010	AS - BUILT		
#4	7/6/2011	AS-BUILT -EXIT SIGNS		

DRAWING TITLE

FIRST FLOOR
EGRESS PLAN

SCALE

1/8"=1'-0"

DRAWN BY

ISSUE DATE

ISSUED FOR BID 01/14/94

CHECKED BY

ARCH. JOB No.

9007

DRAWING TITLE

T-3-1

HHC PROJ. No.


FILE No.

IFA-7419


H-87

CON No.

No. OF SHEETS

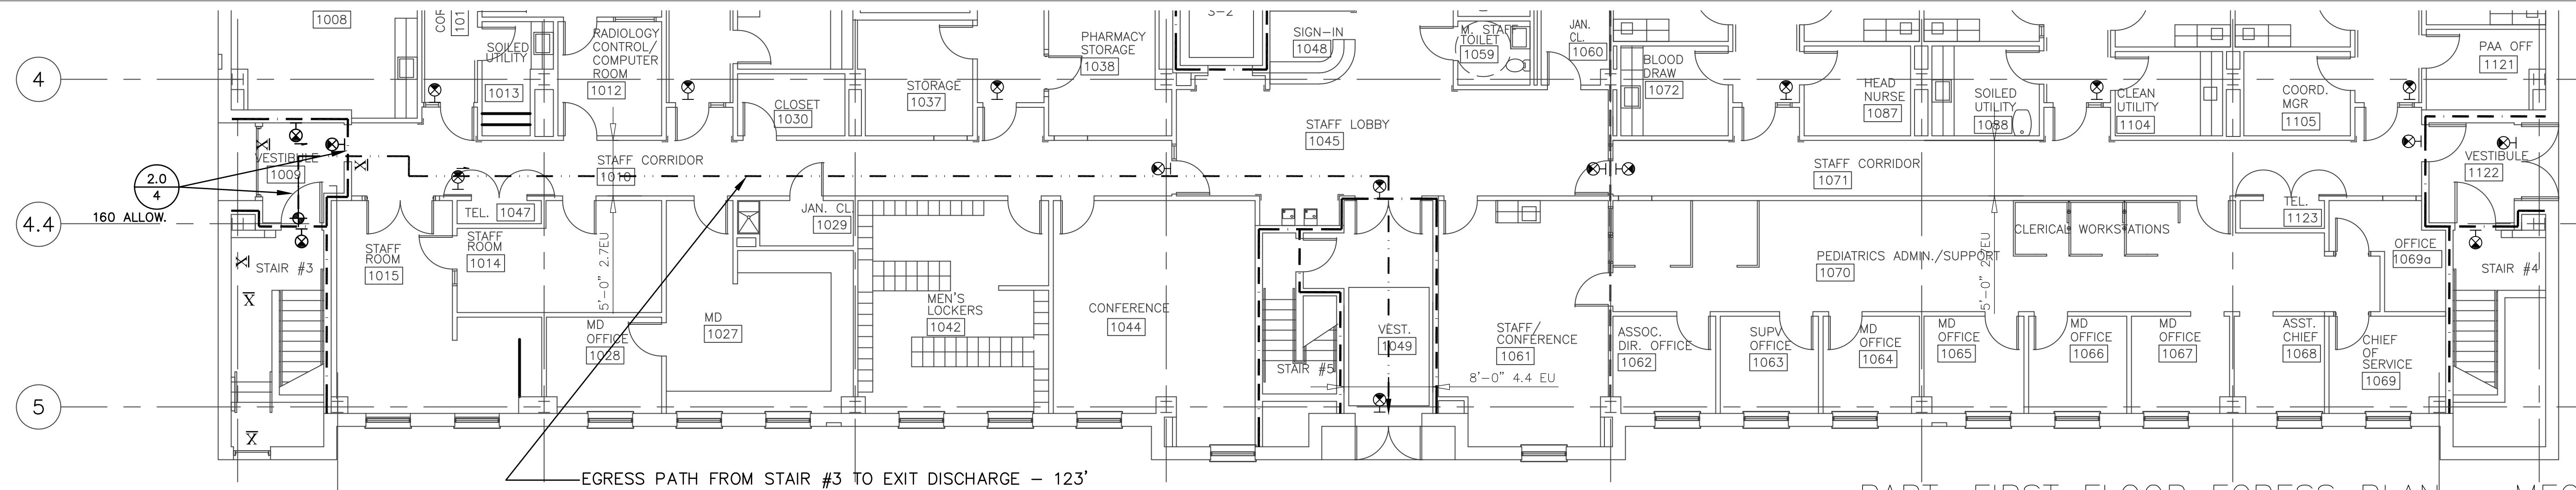

PART. FIRST FLOOR EGRESS PLAN - MECH. BULKHEAD EGRESS

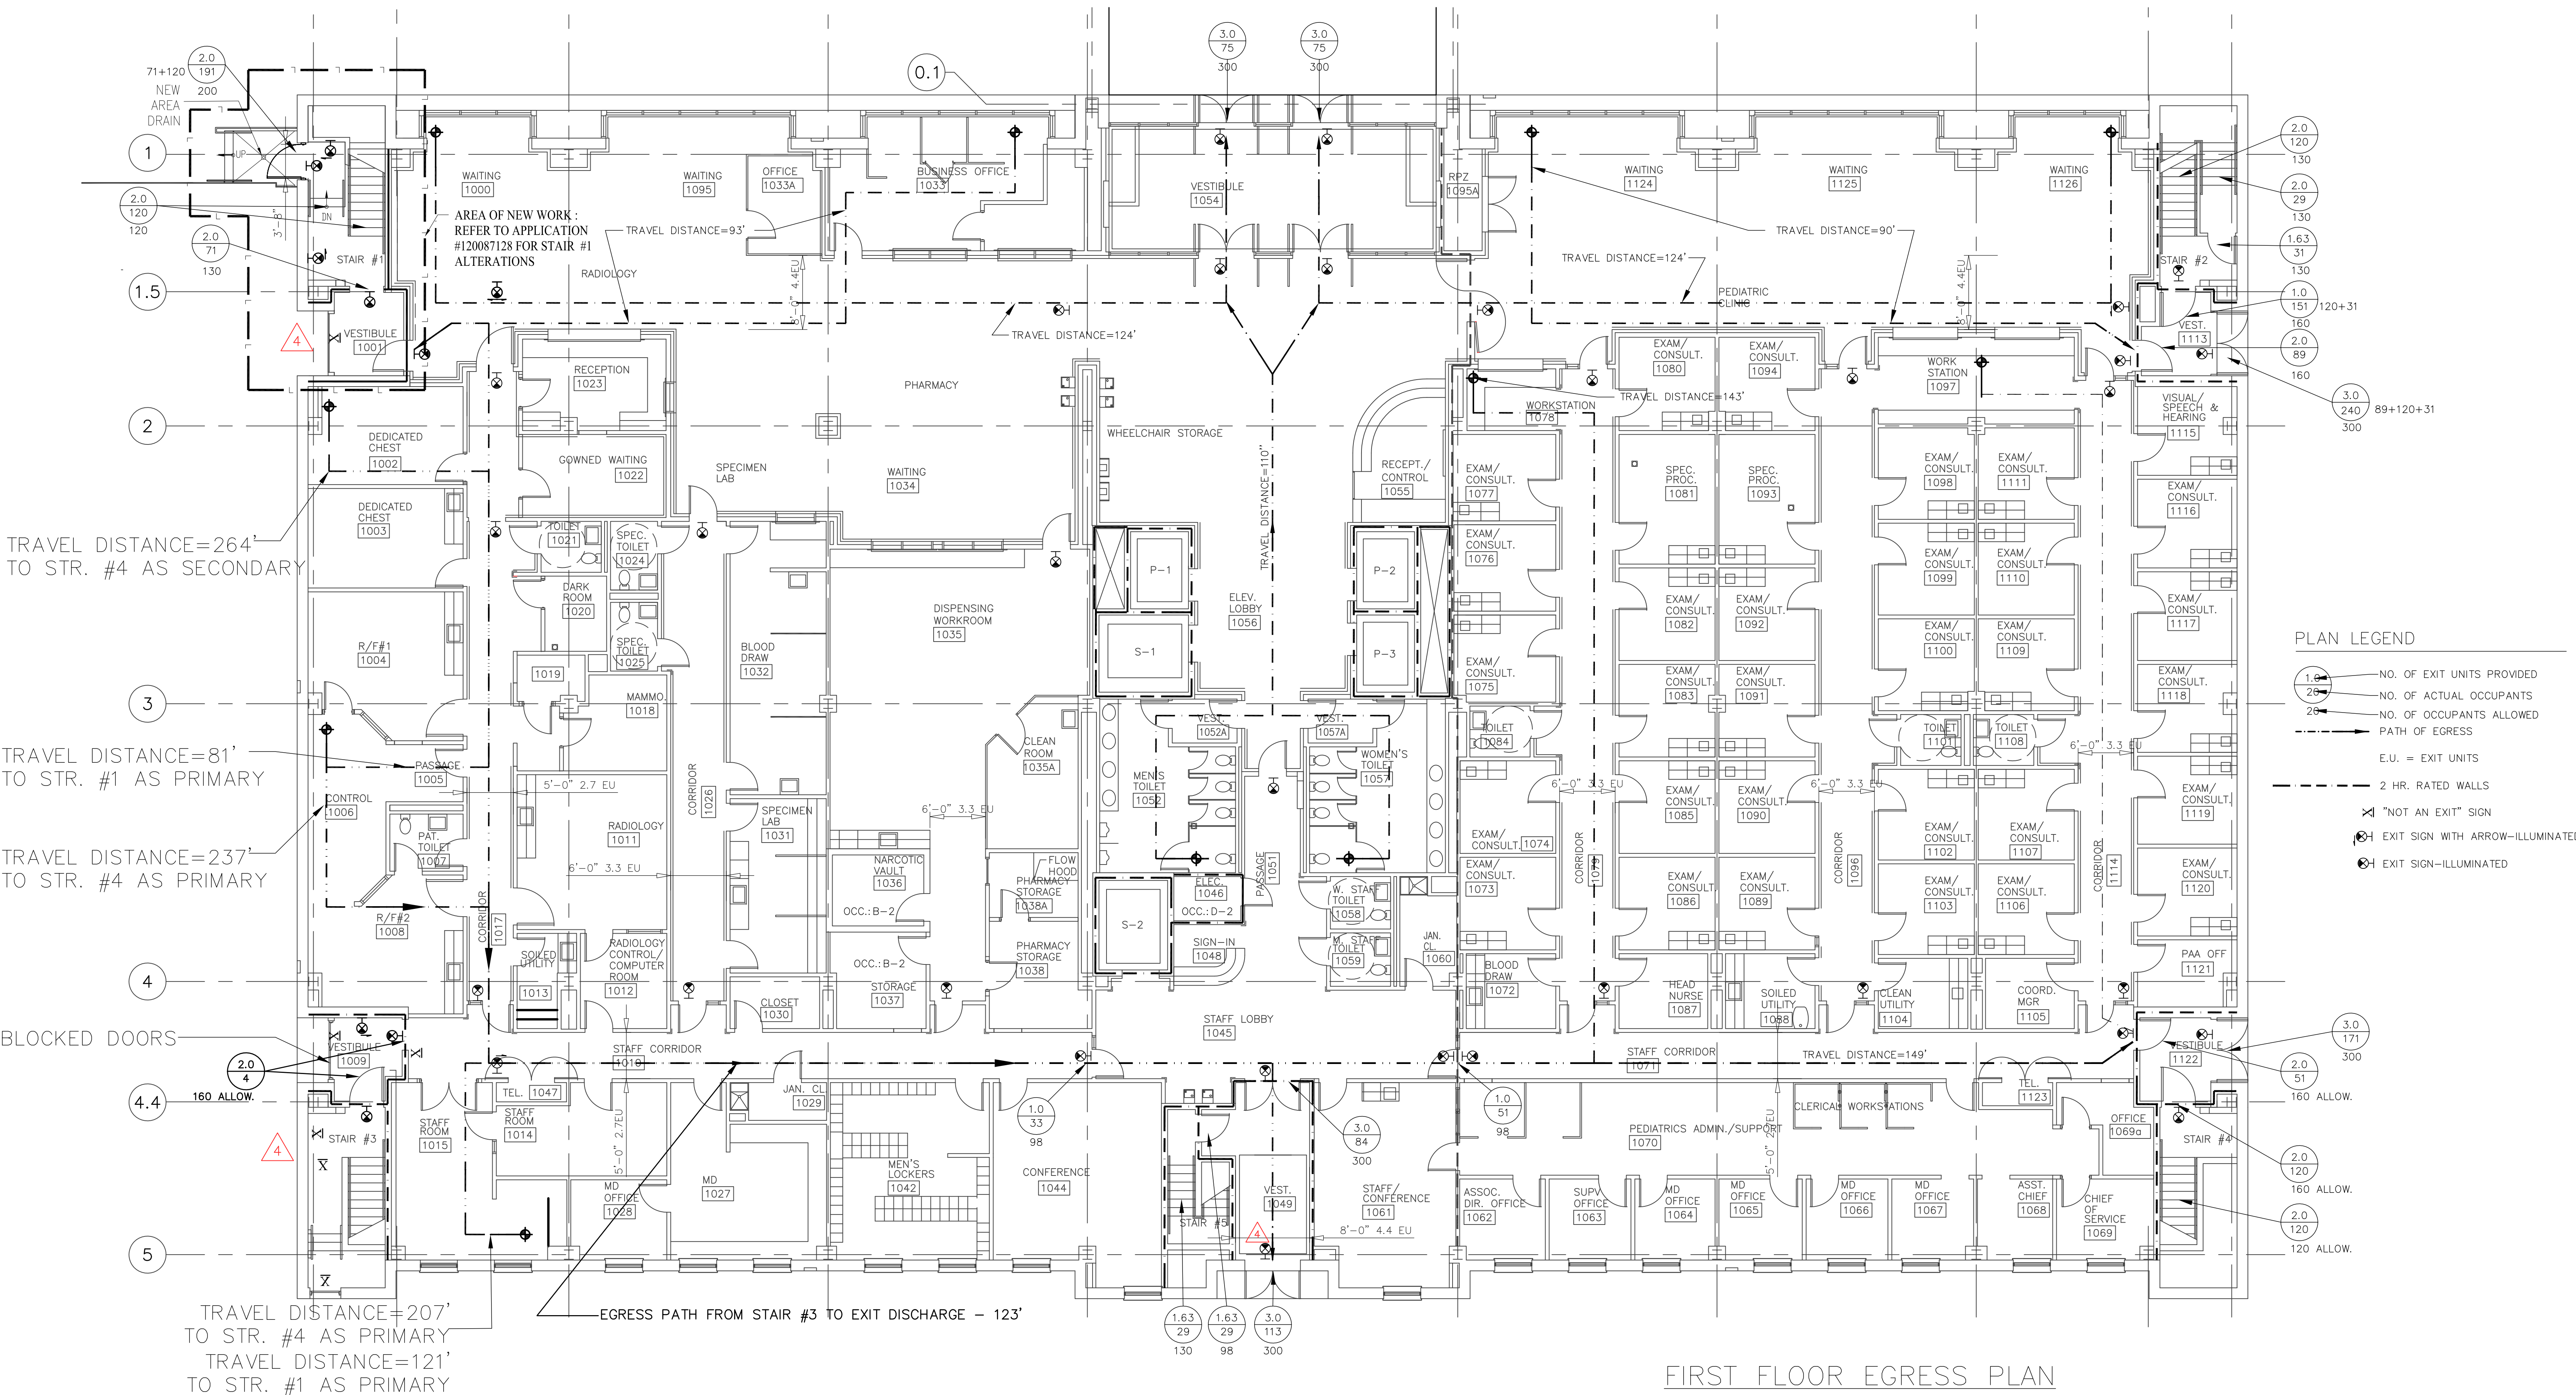

FIRST FLOOR EGRESS PLAN

EXITING REQUIREMENTS

1ST THRU 4TH FLOOR OCCUPANCY CLASS = "E" (TABLE 3-2)

CONSTRUCTION CLASSIFICATION CLASS = "1-D" (TABLE 3-4)

MAX. TRAVEL DISTANCE TO AN EXIT = 300' PRIMARY (TABLE 6-1, "E" SPRINKLERED)

MAX. TRAVEL DISTANCE TO AN EXIT = 300' SECONDARY (TABLE 6-1, "E" SPRINKLERED)

MAX. DEAD END CORRIDOR = 50' (27-359)

NO. OF PERSONS / UNIT OF 22" EXIT WIDTH: (27-359)

GRADE LEVEL EXIT DOORS = 100 PERSONS

ALL OTHER DOORS = 80 PERSONS

STAIRS = 60 PERSONS

HORIZONTAL EXITS = 100 PERSONS

FIRST FLOOR OCCUPANT LOAD

LOBBY/WAITING AREA = 150 PERSONS

STAFF/CLINIC AREA = 219 PERSONS

TOTAL = 369 PERSONS

SEE OCCUPANT LOAD CHART FOR DETAILED OCCUPANT LOADS

NOTE: UNLESS OTHERWISE NOTED, ALL ROOMS ARE "E"
OCCUPANCY

NOTE: ALL WORK WAS
COMPLETED PER NB
APPLICATION #100641049

NEW YORK CITY
HEALTH AND HOSPITALS
CORPORATION
125 WORTH STREET
NEW YORK, N.Y. 10013

HARLEM HOSPITAL CENTER
AMBULATORY CARE BUILDING
506 LENOX AVENUE
NEW YORK, N.Y. 10037

COLES/URS
Robert Traynham Coles, Architect, P.C.
URS Consultants, Inc.

A JOINT VENTURE
62 COOPER SQUARE - 11th FLOOR
NEW YORK, N.Y. 10003-7187


CIVIL ENGINEER
URS CONSULTANTS, INC.
ONE PENN PLAZA, SUITE 610
NEW YORK, NY 10119-0118

STRUCTURAL ENGINEER
URS CONSULTANTS, INC.
23355 MERCANTILE ROAD
CLEVELAND OHIO, 44122-4920


MECHANICAL/ELECTRICAL ENGINEER
HARDIE & ASSOCIATES
838 BROADWAY
NEW YORK, N.Y. 10003

CONSTRUCTION MANAGER
THACKER ENGINEERING, INC.
72 READE STREET - 3RD FLOOR
NEW YORK, N.Y. 10007

SITE KEY PLAN

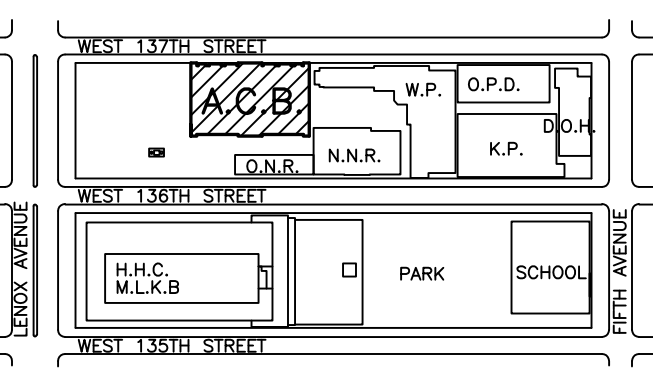

BUILDING KEY PLAN

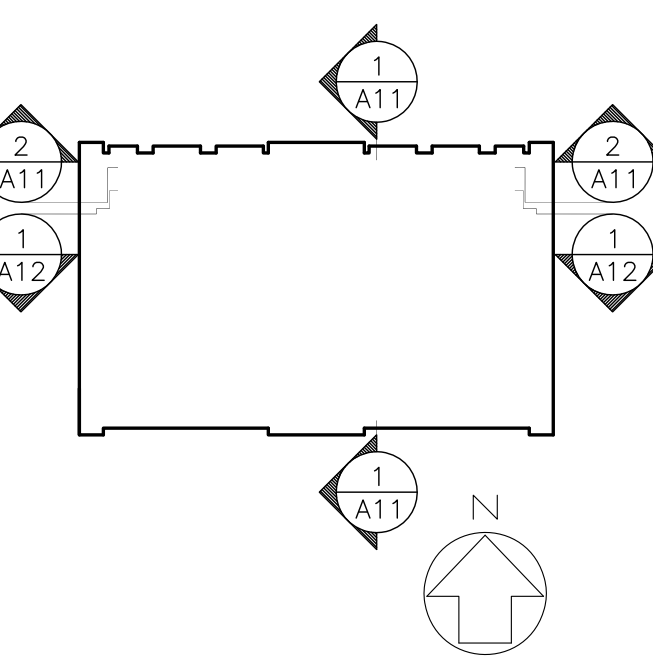

PROJECT

HARLEM HOSPITAL CENTER
AMBULATORY CARE BUILDING
CONSTRUCTION
DOCUMENTS SUBMISSION

CONTRACT No.

REVISIONS

REV#	DATE	DESCRIPTION	DWN	CKD
#1	5/31/94	NYC DOB REVIEW		
#2	7/8/94	DOB REV.-EG. UNITS		
#3	6/12/2010	AS - BUILT		
#4	7/6/2011	AS-BUILT		

DRAWING TITLE

MECH. BULKHEAD
EGRESS PLAN

SCALE 1/8"=1'-0"


DRAWN BY	ISSUE DATE
CHECKED BY	ISSUED FOR BID 01/14/94
	ARCH. JOB No. 9007

DRAWING TITLE

T-4-M

HHC PROJ. No.
IFA-7419
CON No.

FILE No.
H-87
No. OF SHEETS

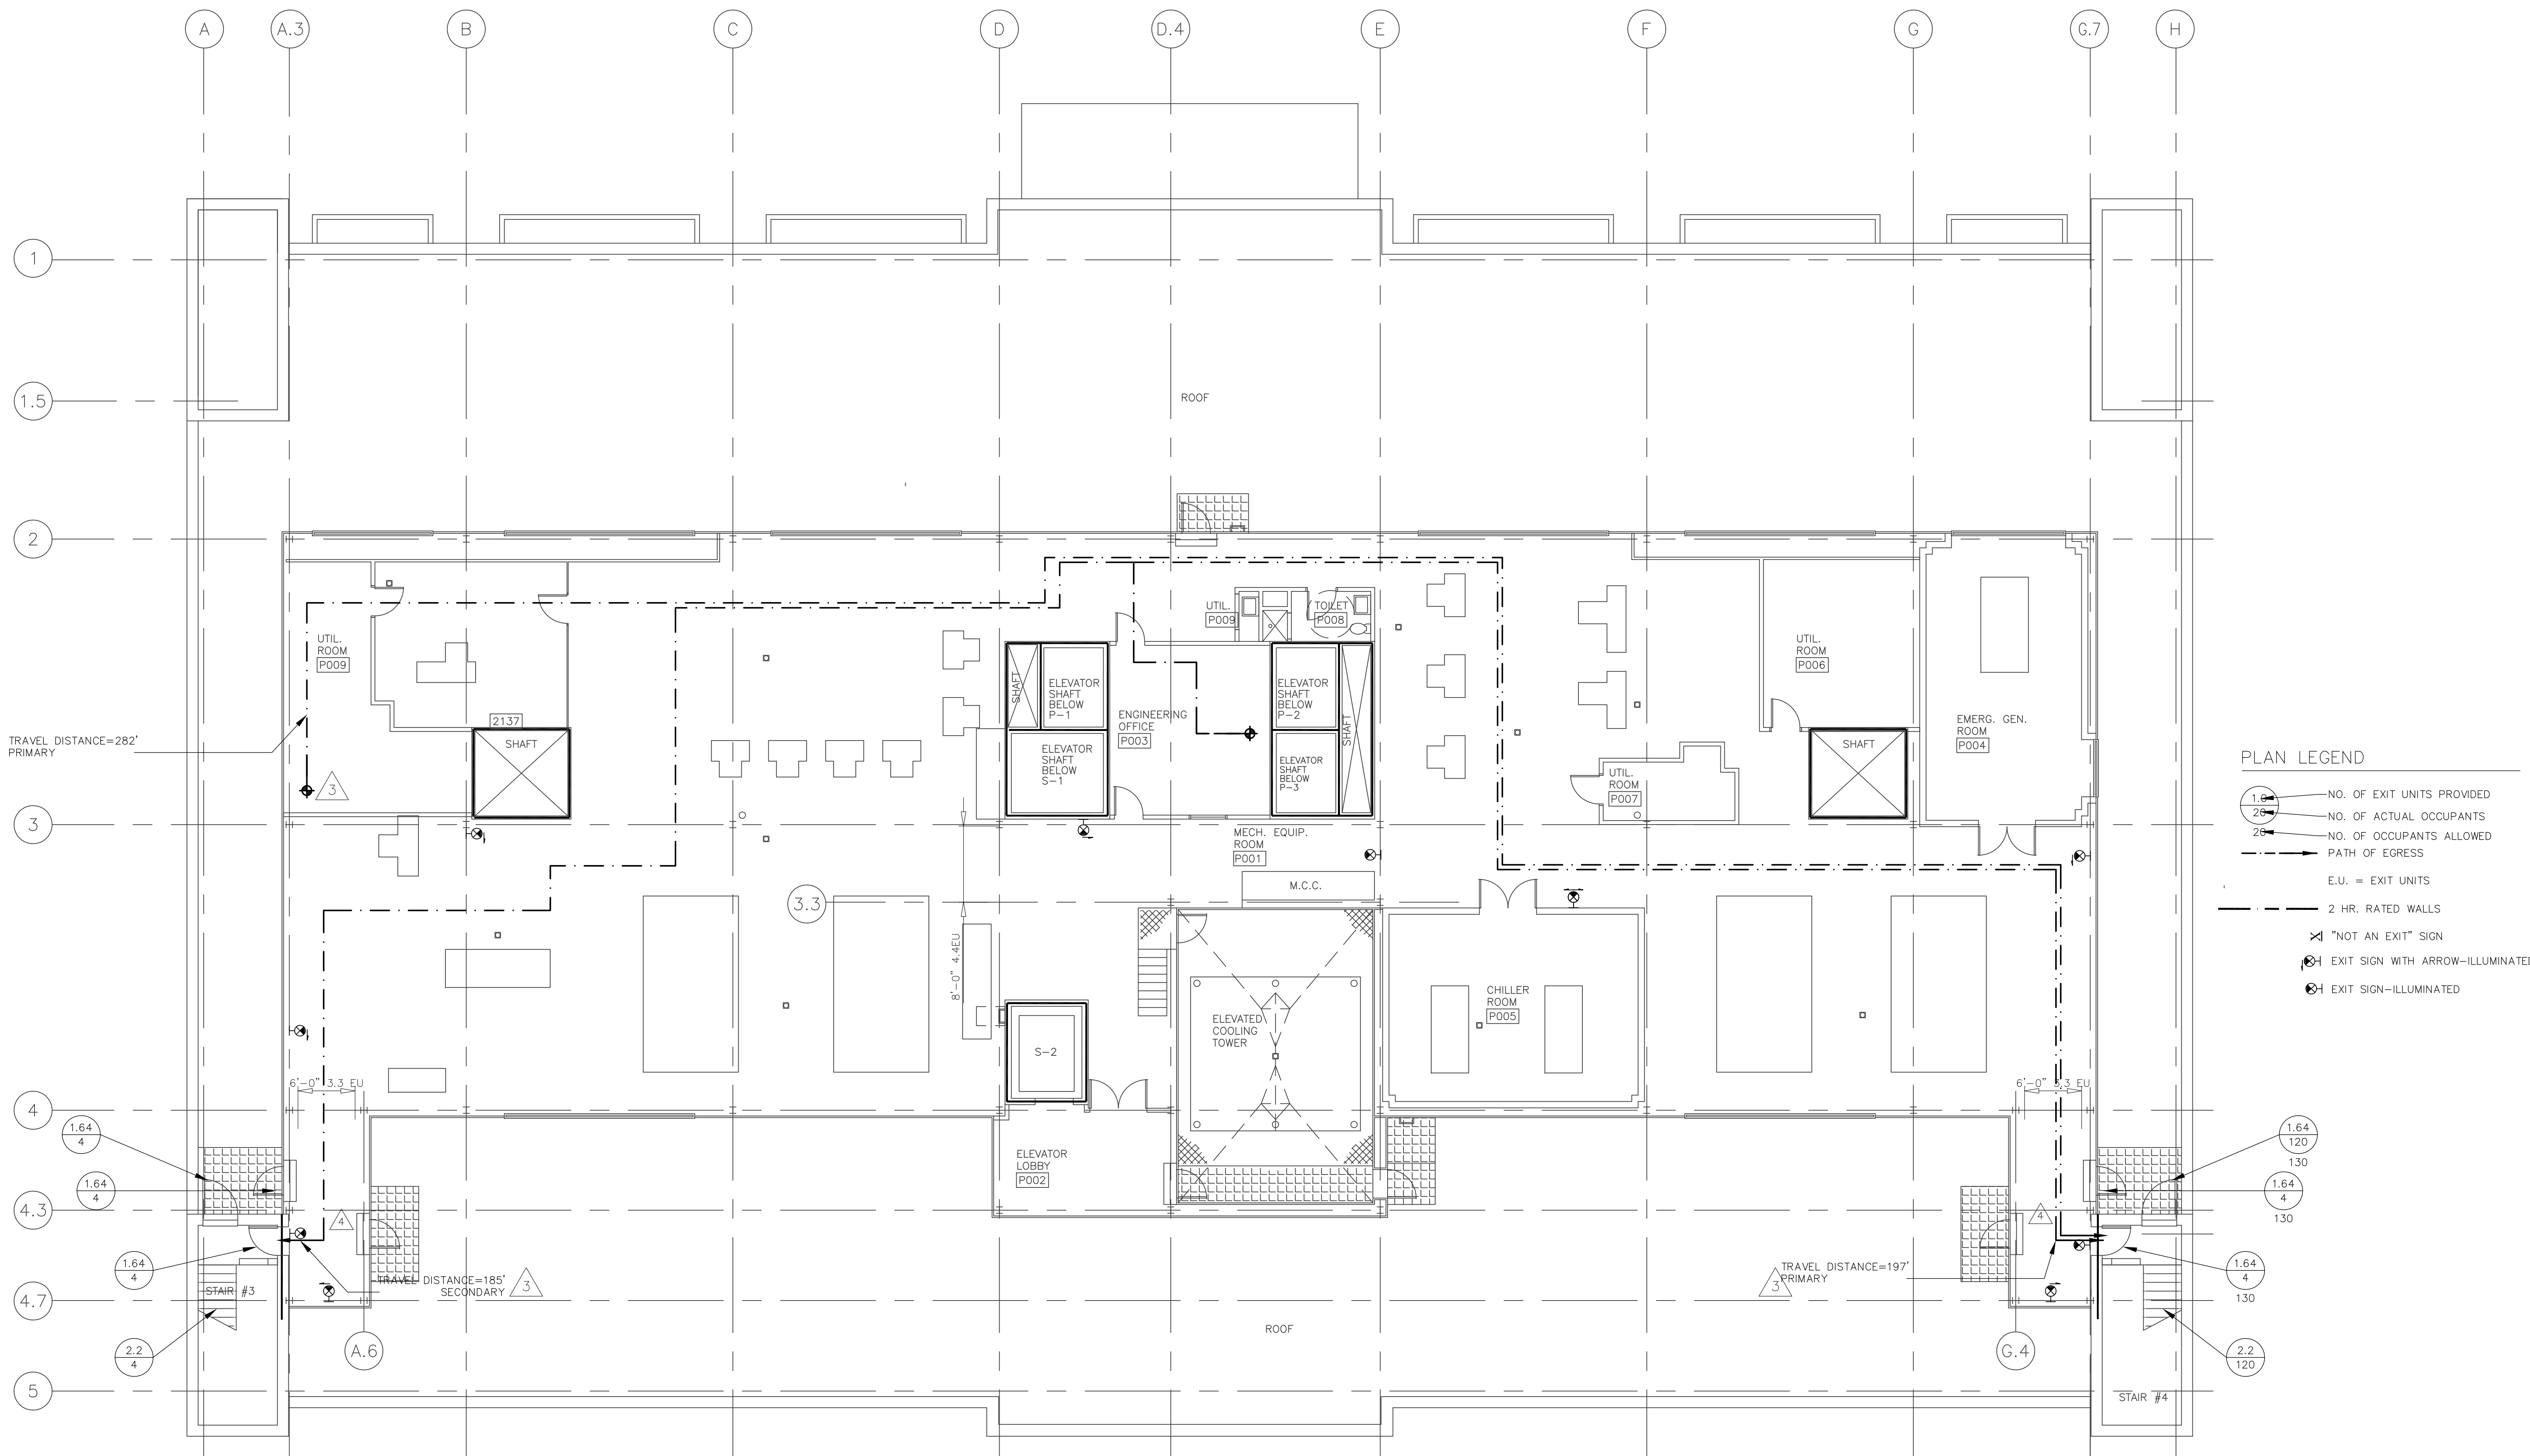

MECHANICAL BULKHEAD OCCUPANT LOAD
ENTIRE AREA = 4 PERSONS
NET AREA = 1,001 S.F.
SEE CELLAR EGRESS PLAN AND OCCUPANT LOAD CHART FOR
ADDITIONAL INFORMATION

NOTE: UNLESS OTHERWISE NOTED, ALL ROOMS
ARE "D-2" OCCUPANCY (TABLE 3-2)